

SMITH

5 M 2

4-5-61

M 302

WATER WELL DRILLERS LOG

Date: 4/5, 19 61, Driller: James A. Vicket County Smith  
(Name)

(1) Owner of Land: Corbett Lullings  
(Name)  
Miss Rt 1  
(Address)

(2) Location: NE 1/4, NE 1/4, Sec. 36 T. 1 R. 7,  
3 miles N, of Miss  
(distance) (direction) (Nearest Town)

(3) Topography: X  
(Hilly) (Flat) (Level)

(4) Purpose of Well: Domestic  
(Domestic Irrigation  
Municipal, Industrial, Other)

Description & Color of Materials Sand, Clay, Red Clay, Shell, etc.	Thick- ness Feet	Depth Feet
Red Clay	16	16
Sand	60	76
Chalk	4	80
Water Sand	20	100

Information upon completion of well:

(1) Diameter 2 inches.

(2) Total Depth 100 feet.

(3) Water Level 80 feet below top of ground.

(4) Cased to 95, Size 2"


(5) Screen: Size 1/4, Length 5 ft.

(6) Were any formations sealed against pollution?  
yes, no.

If YES depth of formation \_\_\_\_\_

Why \_\_\_\_\_

Drillers Remarks: \_\_\_\_\_

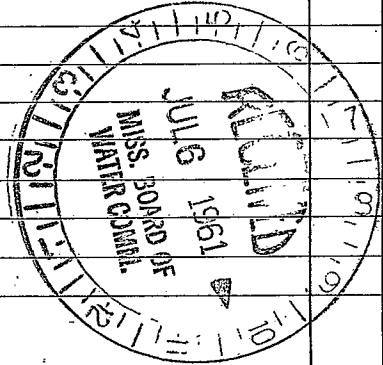

(Use Back Side)

Well No. \_\_\_\_\_

