

SMITH
5 M 3

WATER WELL DRILLERS LOG

0

Date: 8-14-62 1962, Driller: Raymond Smith County: Smith
(Name)


- (1) Owner of Land: Willie B Crockett
(Name)
Rt 2nd north, Miss
(Address)
- (2) Location: 1/4, 1/4, Sec. 9 T 1 R 4E
7 miles NW of Miss
(distance) (direction) (Nearest Town)
- (3) Topography: X
(Hilly) (Flat) (Level)
- (4) Purpose of Well: Domestic
(Domestic Irrigation
Municipal, Industrial, Other)

Description & Color of Materials Sand, Clay, Red Clay, Shell, etc.	Thick- ness Feet	Depth Feet
<u>Red clay</u>	<u>10</u>	<u>10</u>
<u>Sand</u>	<u>10</u>	<u>40</u>
<u>blue shell</u>	<u>8</u>	<u>48</u>
<u>Sand</u>	<u>3</u>	<u>51</u>
<u>blue shell</u>	<u>77</u>	<u>128</u>
<u>Sand</u>	<u>10</u>	<u>138</u>

Information upon completion of well:

- (1) Diameter 2' inches.
- (2) Total Depth 138 feet.
- (3) Water Level 55 feet below top of ground.
- (4) Cased to _____, Size _____.
- (5) Screen: Size 1/4, Length 6 ft.
- (6) Were any formations sealed against pollution?
_____ yes, _____ no.

If YES depth of formation _____
Why _____
Drillers Remarks: _____

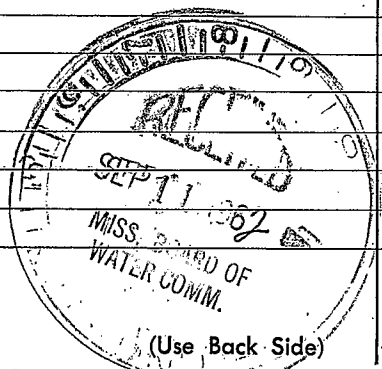

Well No.

Mail this copy to Board of Water Commissioners 429 Miss. St. Jackson, Miss.

