

6 SMITH
M.A.

WATER WELL DRILLERS LOG

Date: 8-14-62 1962, Driller: Wayne White County: Smith
(Name)

(1) Owner of Land: Wesley Allen
(Name)
Rt One Magnolia, Miss.
(Address)

(2) Location: 1/4, 1/4, Sec. 23 T. 1 R. 14
7 miles E of Magnolia
(distance) (direction) (Nearest Town)

(3) Topography: X
(Hilly) (Flat) (Level)

(4) Purpose of Well: Domestic
(Domestic Irrigation
Municipal, Industrial, Other)

Description & Color of Materials Sand, Clay, Red Clay, Shell, etc.	Thick- ness Feet	Depth Feet
<u>Red Clay</u>	<u>12</u>	<u>12</u>
<u>white chalk</u>	<u>18</u>	<u>30</u>
<u>Sand</u>	<u>8</u>	<u>38</u>
<u>white chalk</u>	<u>4</u>	<u>42</u>
<u>Sand</u>	<u>8</u>	<u>50</u>

Information upon completion of well:

(1) Diameter 2" inches.

(2) Total Depth 50 feet.

(3) Water Level 30 feet below top of ground.


(4) Cased to _____, Size _____.

(5) Screen: Size 1/4", Length 5 ft.

(6) Were any formations sealed against pollution?
_____ yes, _____ no.

If YES depth of formation _____
Why _____

Drillers Remarks: _____

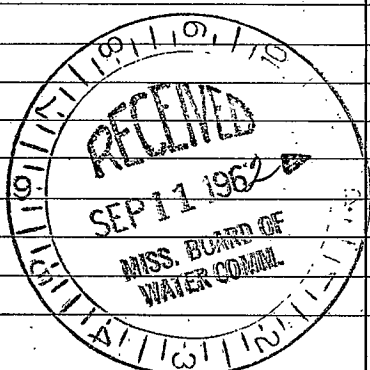

(Use Back Side)

Well No.

Mail this copy to Board of Water Commissioners 429 Miss. St. Jackson, Miss.

