

SMITH

## MISSISSIPPI BOARD OF WATER COMMISSIONERS

6M7

8-20-60

## WATER WELL DRILLERS LOG

AA-301

Date: 8/20, 1960, Driller: James A. White, Cullen Smith

(Name)

County Smith

(1) Owner of Land: Cullen Smith  
(Name)Mize R1 Mrs  
(Address)

(2) Location: ¼, ¼, Sec. 8 T. 1 R. 6

6 miles north, of Mize  
(distance) (direction) (Nearest town)(3) Topography: X  
(Hilly) (Flat) (Level)(4) Purpose of Well: Domestic Ties  
(Domestic Irrigation  
Municipal, Industrial, Other)

## Information upon completion of well:

(1) Diameter 2 inches.

(2) Total Depth 140 feet.

(3) Water Level 120 feet below top of ground.

(4) Cased to 129, Size 2

(5) Screen: Size 1 3/4, Length 11 ft.

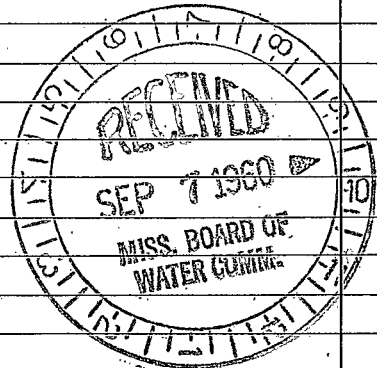
(6) Were any formations sealed against pollution?

yes, X no.

If YES depth of formation \_\_\_\_\_

Why \_\_\_\_\_

Drillers Remarks: \_\_\_\_\_

Description & Color of Materials  
Sand, Clay, Red Clay, Shell, etc.Thick-  
ness  
FeetDepth  
FeetRed clay 19  
Sand 171

(Use Back Side)

Well No.

Mail this copy to Board of Water Commissioners 429 Miss. St. Jackson, Miss.

