

M 8

9-20-62

WATER WELL DRILLERS LOG

Date: Sept. 20 1962, Driller: W. H. Butler County Smith

(Name)

(1) Owner of Land: Bob Garner  
(Name)

Madge, Rt 3, Miss  
(Address)

(2) Location: 1/4, 1/4, Sec 25 T2R7E

11 miles South W. of Raleigh  
(distance) (direction) (Nearest Town)

(3) Topography:  (Hilly)  (Flat)  (Level)

(4) Purpose of Well: DOMESTIC  
(Domestic Irrigation, Municipal, Industrial, Other)

Description & Color of Materials Sand, Clay, Red Clay, Shell, etc.	Thick- ness Feet	Depth Feet
Clay + Chalk	1-10	
Rock	10-38	
Rock + Chalk	30-50	
Chalk + sand	50-60	
Rock	60-70	
Chalk	70-90	
Rock	90-140	
Sand + Chalk	140-155	
Chalk	155-160	
Sand	160-175	
Sand + Chalk	175-180	

Information upon completion of well:

(1) Diameter 2 inches.

(2) Total Depth 180 feet.

(3) Water Level 90 feet below top of ground.

(4) Cased to 168', Size 2"


(5) Screen: Size 2", Length 5'

(6) Were any formations sealed against pollution?  
yes, no.

If YES depth of formation \_\_\_\_\_

Why \_\_\_\_\_

Drillers Remarks: \_\_\_\_\_

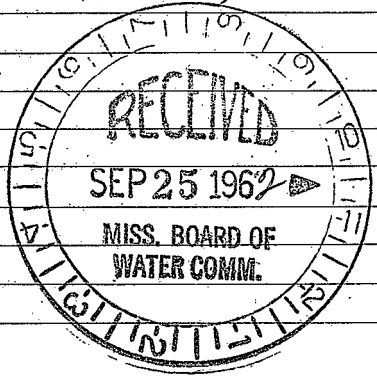

(Use Back Side)

Well No.

