

SMITH
M13
11-4-71

MISSISSIPPI
BOARD OF WATER COMMISSIONERS
416 North State Street
Jackson, Mississippi 39201

CODED

WATER WELL DRILLERS LOG

11/4 1977 *P. Parker Water Well Drilling* *Barrett*
date well completed firm name county well located

LANDOWNER: *Jeremy Wilson*
Mike Mess
(mailing address)

description of formations encountered	from	to
<i>Red coarse sand</i>	<i>0</i>	<i>50</i>
<i>white chalky sand</i>	<i>50</i>	<i>110</i>
<i>gray chalky</i>	<i>110</i>	<i>180</i>
<i>white sand</i>	<i>180</i>	<i>190</i>
<i>green chalk</i>	<i>190</i>	<i>200</i>
<i>gray coarse sand</i>	<i>200</i>	<i>220</i>

WELL LOCATION:
sec. *32* T *1* N R *16* E
S *W*
2 miles *west* of *Mike*
(distance) (direction) (nearest town)

WELL PURPOSE: *HOME*
(home, irrigation, municipal, industrial)

WELL COMPLETION DATA:

(1) diameter (inches) *2*

(2) total depth (feet) *220*

(3) static water level (feet) *80* ^{below} _{above} top of ground.

(4) casing *galv* *215*
(material) (depth)
(size) If telescope see back.

(5) screen *5ft* *220*
(length) (depth to top)
1 1/4 *3/8*
(size) (material)

(6) pump *1* *5*
(HP) (yield gpm)
jet elec.
(type power)

(7) electric log _____
(yes or no)
(organization running log)

(8) how well bottom plugged *chalk*

CODED


DRILLERS REMARKS:

NOV 8 - 1977

MISS. BD. OF
WATER COMM.

If well telescopes please sketch and show depths.

GROUND LEVEL

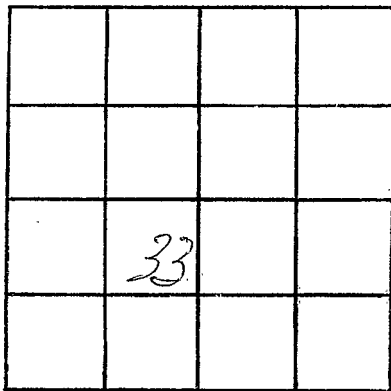

R16W

SECTION 33

Please indicate well location X.

ADDITIONAL INFORMATION

go to mesa go west
on 28 take first
right go to Shady Grove
church park house next
house Pass church

If more than one screen,
show locations of each on sketch.