

Smith  
M 14  
8-15-75

C. P. CLARK  
MISSISSIPPI WATER WELL DRILLING  
BOARD OF WATER COMMISSIONERS ROUTE 2  
416 North State Street LAUREL, MISS. 39040  
Jackson, Mississippi 39201

CODED 140

WATER WELL DRILLERS LOG

8/15 1975 C.P. Clark Smith  
date well completed firm name county well located

LANDOWNER:	description of formations encountered	from	to
T. J. Stebbins	Sandy Clay	0	7
Miss Miss (mailing address)	Clay	7	88
	Fine Sand (very fine)	88	94
WELL LOCATION:	Fine Sand + Clay	94	96
sec. 32 T-1 N R-7 E 13 Q	Clay	96	105
2 miles NW of Miss	Very fine Sand	105	109
(distance) (direction) (nearest town)	Coarse fine Sand	109	129
WELL PURPOSE: Barn	Hard Chattering rock	129	130
(home, irrigation, municipal, industrial)	Clay	130	138
WELL COMPLETION DATA:	Hard Chattering rock	138	138 1/2
(1) diameter (inches) 2	Clay	138 1/2	146
(2) total depth (feet) 200	Hard Chattering rock	146	146 1/2
(3) static water level (feet) 75 below above top of ground.	Clay	146 1/2	175
(4) casing Galvneon 8" (material) (depth)	Clay + fine Sand streaks	175	200
(size) if telescope see back.			
(5) screen None (length) (depth to top)			
(size) (material)			
(6) pump 1 1/2 5 (HP) (yield gpm)			
(type power) Electric			
(7) electric log No (yes or no)			
(organization running log)			
(8) how well bottom plugged Open			
DRILLERS REMARKS: Water coming from 98 ft to 146 1/2. Most of water coming out of rock formation			


CODED

RECEIVED  
SEP 15 1975

MISS. DD. OF WATER

If well telescopes please sketch and show depths.

GROUND LEVEL

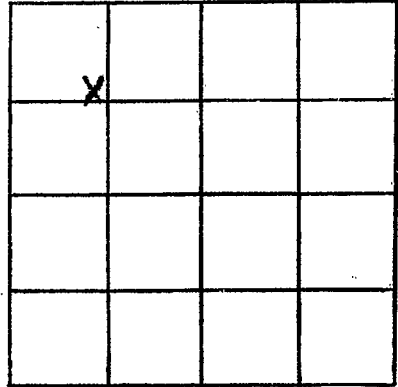

SECTION 32

Please indicate well location X.

ADDITIONAL INFORMATION

If more than one screen, show locations of each on sketch.