

Smith

M-15
6-21-80

MISSISSIPPI
BOARD OF WATER COMMISSIONERS
416 North State Street
Jackson, Mississippi 39201

CODED

WATER WELL DRILLERS LOG

6-20-80 *Triner Drilling Smith*
date well completed firm name county well located

LANDOWNER:
Pruett Production
1515 Capital Tower
Jackson, MS 39205
(mailing address)

description of formations encountered	from	to
<i>sand, gravel</i>	<i>0</i>	<i>231</i>
<i>chalk</i>	<i>231</i>	<i>378</i>
<i>streaked</i>	<i>378</i>	<i>483</i>
<i>chalk</i>	<i>483</i>	<i>562</i>
<i>sand</i>	<i>562</i>	<i>588</i>
<i>chalk</i>	<i>588</i>	<i>630</i>
<i>shell</i>	<i>630</i>	<i>635</i>

WELL LOCATION: *3501 N + 1833 W*
No 1 *35* T *1* R *6* E of *80* sec *1* *W*
Lavon *Womack* *Magge - Miss*
35-15 (distance) (direction) (nearest town)

WELL PURPOSE: *oil field*
(home, irrigation, municipal, industrial)

WELL COMPLETION DATA:
(1) diameter (inches) *3"*
(2) total depth (feet) *635'*
(3) static water level (feet) *175'* *below* above top of ground.
(4) casing *steel 588'*
(material) (depth)
3"
(size) If telescope see back.
(5) screen *42' 546'*
(length) (depth to top)
3" *perforated*
(size) (material)
(6) pump *70*
(HP) (yield gpm)
AC
(type power)
(7) electric log *—*
(yes or no)
(organization running log)

CODED

DEPT. OF NATURAL RESOURCES
BUREAU OF LAND & WATER RESOURCES

JUL 14 1980


RECEIVED

(8) how well bottom plugged *range*
peel

DRILLERS REMARKS:

If well telescopes please
sketch and show depths.

GROUND LEVEL

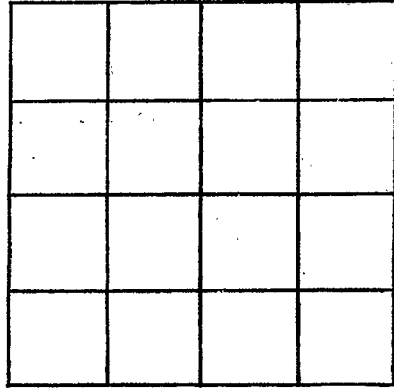

SECTION _____

Please indicate well location X.

ADDITIONAL INFORMATION

If more than one screen,
show locations of each on sketch.