

M17
 Smith
 8-23-85

MISSISSIPPI
 BOARD OF WATER COMMISSIONERS
 416 North State Street
 Jackson, Mississippi 39201

CODED

WATER WELL DRILLERS LOG

Griner Drilling
 Service, Inc.

Smith

8-23-85
 date well completed

Griner Drilling
 Service, Inc.
 firm name

Smith
 county well located


LANDOWNER:	description of formations encountered	from	to
Helmerich and Payne 5401 South Hattie Oklahoma City, Oklahoma (mailing address) 73129	hard clay	0	100
WELL LOCATION: 1980' N + 64' W sec. 5 T. 1 (N) S R. 7 (E) W S. 100 No. 1-5 Amex miles of (distance) (direction) (nearest town)	streaked, rocky	100	336
WELL PURPOSE: oilfield supply (home, irrigation, municipal, industrial)	streaked	336	400
WELL COMPLETION DATA: (1) diameter (inches) 3" (2) total depth (feet) 819' (3) static water level (feet) 120' below top of ground. (4) casing steel, 777' (material) (depth) 3" (size) if telescope see back. (5) screen 42' 735' (length) (depth to top) 3" perforated (size) (material) (6) pump - 80-90 (HP) (yield gpm) AC (type power) (7) electric log (yes or no) (organization running log) (8) how well bottom plugged orange peel	clay	400	683
	sand, shell	683	735
	sand	735	777
DRILLERS REMARKS:	streaked sand	777	819

RECEIVED
 SEP 23 1985

Department of Natural Resources
 Bureau of Land & Water Resources

If well telescopes please sketch and show depths.

GROUND LEVEL

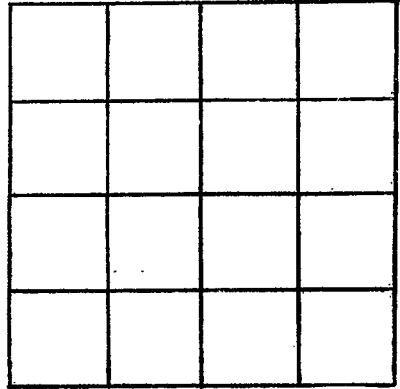

SECTION _____

Please indicate well location X.

ADDITIONAL INFORMATION

If more than one screen,
show locations of each on sketch.