

State Well Report

Part 1

Mississippi Department of Environmental Quality
Office of Land and Water Resources
P.O. Box 10631
Jackson, MS 39289-0631
(601)961-5210
(601)354-6938 (fax)

For Office Use Only:

Aquifer: _____
Well #: M-30
L. S. Elevation: _____
E-log #: _____

County: Smith
Permit #: _____
Driller: Gary Rayborn
Date drilling completed: 5-13-08

State Law requires that this report be prepared by the driller in detail and filed with the Department within 30 days of completion of drilling of the well.

| Well Owner Information | Well Location |
|---|---|
| Owner Name: <u>D+D Drilling, Inc.</u> | Latitude: _____ Longitude: _____ |
| Mailing Address: <u>P.O. Box 1634</u> | Method of Lat/Long (circle one): Conventional Survey, USGS quad, Hand-held GPS, Survey-grade GPS |
| <u>Ferriday, LA 71334</u> City State Zip Code | ____ 1/4 ____ 1/4 Sec <u>16</u> Twn <u>1N</u> Rng <u>7E</u> |
| Telephone No. (<u>318</u>) <u>757-3274</u> | Distance <u>1.2</u> Miles Direction <u>N</u> of Nearest Town <u>Mize</u> |
| Well Data | |
| Purpose of Well (circle one) Home Industrial Public Supply Irrigation Fish Culture <u>Other: Rig Supply</u> | |
| Date well drilling started: <u>5/13/08</u> Date well drilling completed: <u>5/13/08</u> | |
| If flowing, method of flow regulation: Valve _____ Other (describe) _____ | |
| Static Water Level: <u>70</u> feet above or <u>below</u> (circle one) land surface Date measured: <u>5/13/08</u> | |
| Method of Measurement (circle one) steel tape <u>electric tape</u> air line other: _____ | |
| Hole depth: <u>180'</u> Well depth: <u>180'</u> Well grouted to a depth of <u>10</u> feet | |
| Type of grout (circle one): <u>Cement</u> Bentonite Mix | |
| Casing length: <u>140</u> feet Casing diameter: <u>4</u> inches Type of casing: <u>PVC</u> | |
| Screen length: <u>40</u> feet Screen diameter: <u>4</u> inches Type of screen: <u>PVC</u> | |
| Screen slot size: <u>.020</u> inches Setting depth: From <u>140</u> feet to <u>180</u> feet | |
| Type of completion (circle all applicable): <u>Gravel packed</u> Underreamed Telescoped Open hole Natural Development | |
| Other (describe): _____ | |
| Top of lap pipe or reduction in casing: _____ feet. If telescoped or more than one screen, describe on back of page | |
| Logs run (circle all applicable): <u>No log run</u> Electric Gamma Ray Density Sonic Neutron Other: _____ | |
| Name of organization running log(s): _____ | |
| I certify that the well was drilled, constructed, and completed in accordance with all applicable requirements of the Mississippi Department of Environmental Quality and/or the Mississippi Department of Health regulations and state laws. | |
| <u>RAYBORN DRILLING, INC.</u> | <u>D-60</u> |
| Print Name of Water Well Contractor and License No. | Signature of Water Well Contractor |

RECEIVED

MAY 28 2008

BY: OLWR


If well telescopes please sketch below and show depths.

Ground Level

| Description of Formations Encountered | From | To |
|---------------------------------------|------|-----|
| Chalk | 0 | 20 |
| SAND | 20 | 35 |
| HARD CHALK | 35 | 80 |
| HARD Chalk & limestone | 80 | 120 |
| SILTY CLAY | 120 | 140 |
| Fine SAND | 140 | 180 |
| | | |
| | | |
If more than one screen, show location of each on sketch

Sketch the property layout and include the following: 1) the well location; 2) any permanent structures on the property that may aid in locating the well; 3) any roads, power lines, or other items that may aid in locating the property and the well; 4) indicate direction.

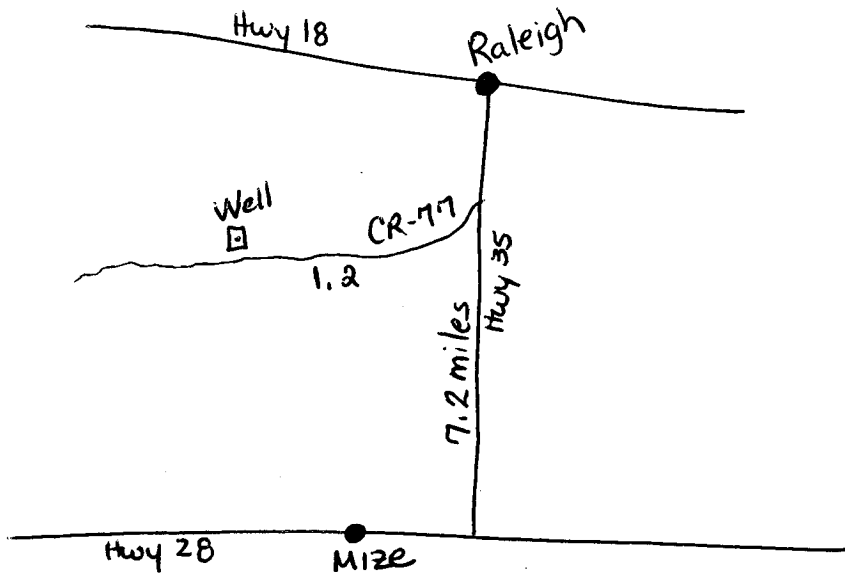

Landowner Name: _____

Signature of Water Well Contractor

RECEIVED
MAY 28 2008
BY: OLWR

STATE WELL REPORT

Part 2

Pump Installer's Completion Report
 Mississippi Department of Environmental Quality
 Office of Land and Water Resources
 P.O. Box 10631
 Jackson, MS 39289-0631
 (601)961-5210
 (601)354-6938 (fax)

County: Smith
 Permit #: _____
 Driller: Gary Rayborn
 Date completed: 5-13-08

For Office Use Only:

Aquifer: _____
 Well #: M-30
 Elevation: _____

This report should be prepared by the pump installer in detail and filed with the Department within 30 days of the installation of pump.

| Well Owner Information | Well Location |
|---------------------------------------|---|
| Owner Name: <u>D+D Drilling, Inc.</u> | Latitude: _____ Longitude: _____ |
| Mailing Address: <u>P.O. Box 1634</u> | Method of Lat/Long (circle one): Conventional Survey, |
| <u>Ferriday, LA 71334</u> | USGS quad, Hand-held GPS, Survey-grade GPS |
| City State Zip Code | _____ ¼ _____ ¼ Sec <u>16</u> Twn <u>1N</u> Rng <u>7E</u> |
| Telephone No. <u>(318) 757-3274</u> | Distance Direction Nearest Town |
| | <u>7.2</u> Miles <u>N</u> of <u>Misc</u> |

| Pump Type Circle one | Power Type Circle one |
|--|---|
| Air Lift Jet <input checked="" type="radio"/> <u>Submersible</u> | Diesel Engine Gasoline Engine Natural Gas |
| Bucket Piston Turbine | <input checked="" type="radio"/> <u>Electric Motor</u> Hand Tractor PTO |
| Centrifugal Rotary Flowing Well | Windmill Other (specify): _____ |
| Other (specify): _____ | Horse Power Rating of Motor: <u>5 HP</u> |
| Date Pump Installed: <u>5-13-08</u> | Setting Depth: <u>168</u> feet |
| Rated Pump Capacity: <u>60</u> Gallons Per Minute | Number of Stages: <u>11</u> |

| Pump Test Data | Method of Measuring Water Level Circle one |
|---|---|
| Date Well Tested: <u>5-13-08</u> | Air Line <input checked="" type="radio"/> <u>Electric Measuring Line</u> Steel Tape |
| Static Water Level (A): <u>70</u> Feet Below Land Surface | Other (specify): _____ |
| Pumping Water Level (B): _____ Feet Below Land Surface | For flowing well, measured shut in head: _____ feet |
| Drawdown [(B) - (A)]: _____ Feet Below Land Surface | Well yielded <u>60</u> GPM with a drawdown of |
| Test Pumping Rate: <u>60</u> Gallons Per Minute | _____ feet after _____ hours of pumping |
| Duration of Pump Test (minimum 4 hours): _____ hours | |

I HEREBY CERTIFY that the above statements are true to the best of my knowledge.

Gary Rayborn 0-60 _____
 Print Name of Pump Installer and License No. (if applicable) Signature of Pump Installer

RECEIVED
 MAY 28 2008
 BY: OLWR