

Sep 19 08 09:52a

WEST WATER WELL DRILLING

6014262154

p.1

State Well Report

Part 1

Mississippi Department of Environmental Quality
Office of Land and Water Resources
P.O. Box 10631
Jackson, MS 39289-0631
(601)961-5210
(601)354-6938 (fax)

For Office Use Only:

Acquirer: _____
Well #: M-33
E. S. Elevation: _____
E-log #: _____

County: Smith
Permit #: _____
Driller: David West
Date drilling completed: 8-20-08

State Law requires that this report be prepared by the driller in detail and filed with the Department within 30 days of completion of drilling of the well.

Well Owner Information	Well Location
Owner Name: <u>Junior Cockrell</u>	Latitude: <u>31.56</u> ° Longitude: <u>81.37</u> °
Mailing Address: <u>649 SCR 61</u>	Method of Lat/Long (circle one): <input type="checkbox"/> Conventional Survey, <input type="checkbox"/> USGS quad, <input type="checkbox"/> Hand-held GPS, <input type="checkbox"/> Survey-grade GPS
<u>Mize</u> <u>MS</u> <u>39116</u>	<u>NW 1/4 NE 1/4</u> Sec <u>18</u> Twn <u>1N</u> Rng <u>7E</u>
City State Zip Code	Distance Direction Nearest Town
Telephone No. <u>(601) 733-5389</u>	<u>5</u> Miles <u>NW</u> of <u>MIZE</u>

Well Data

Purpose of Well (circle one) Home Industrial Public Supply Irrigation Fish Culture Other: Livestock

Date well drilling started: 8-20-08 Date well drilling completed: 8-20-08

If flowing, method of flow regulation: Valve _____ Other (describe) _____

Static Water Level: 95 feet above or below (circle one) land surface Date measured: 8-20-08

Method of Measurement (circle one) steel tape electric tape air line other: _____

Hole depth: 160 Well depth: 160 Well grouted to a depth of 10 feet

Type of grout (circle one): Cement Bentonite Mix

Casing length: 140 feet Casing diameter: 4 inches Type of casing: PVC

Screen length: 20 feet Screen diameter: 4 inches Type of screen: PVC

Screen slot size: .010 inches Setting depth: From 140 feet to 160 feet

Type of completion (circle all applicable): Gravel packed Underreamed Telescoped Open hole Natural Development

Other (describe): _____

Top of log pipe or reduction in casing: _____ feet. If telescoped or more than one screen, describe on back of page

Logs run (circle all applicable): No log run Electric Gamma Ray Density Sonic Neutron Other: _____

Name of organization running log(s): _____

I certify that the well was drilled, constructed, and completed in accordance with all applicable requirements of the Mississippi Department of Environmental Quality and/or the Mississippi Department of Health regulations and state laws.

David West 0-672
Print Name of Water Well Contractor and License No.

David West
Signature of Water Well Contractor

RECEIVED

SEP 18 2008
BY: OLWR

Sep 19 08 09:52a

WEST WATER WELL DRILLING


6014262154

p.3

M-33

If well telescopes please sketch below and show depths.

Ground Level

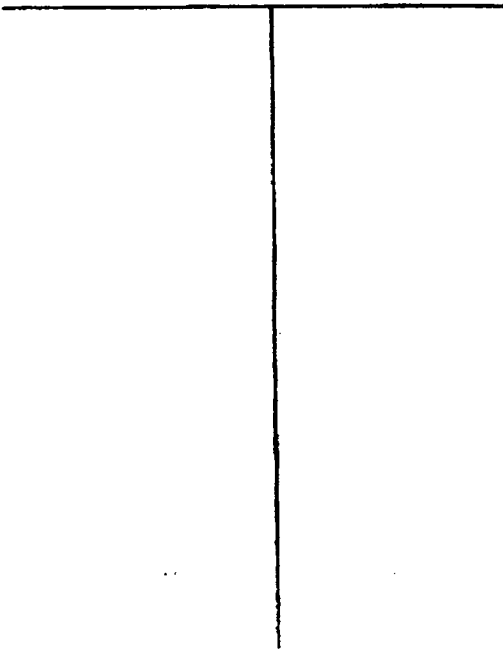

Description of Formations Encountered	From	To
Clay	0	23
Sand	23	74
Clay	74	131
Sand	131	160

If more than one screen, show location of each on sketch

Sketch the property layout and include the following: 1) the well location; 2) any permanent structures on the property that may aid in locating the well; 3) any roads, power lines, or other items that may aid in locating the property and the well; 4) indicate direction.

Landowner Name: Junior Lockrell

David R. Walker
 Signature of Water Well Contractor

RECEIVED
 SEP 18 2008
 BY: OLWR

Sep 19 08 09:52a

WEST WATER WELL DRILLING

6014262154

p.2

STATE WELL REPORT

Part 2

Pump Installer's Completion Report
 Mississippi Department of Environmental Quality
 Office of Land and Water Resources
 P.O. Box 10631
 Jackson, MS 39289-0631
 (601)961-5210
 (601)354-6938 (fax)

For Office Use Only:

Acquirer:

Well #: M-33

Elevation:

County: Smith
 Permit #: _____
 Driller: David West
 Date completed: 8-20-08

This report should be prepared by the pump installer in detail and filed with the Department within 30 days of the installation of pump.

Well Owner Information	Well Location
Owner Name: <u>Junior Coakren</u>	Latitude: <u>31°56'</u> Longitude: <u>81°37'</u>
Mailing Address: <u>649 SCR 61</u>	Method of Lat/Long (circle one): Conventional Survey, USGS quad, Hand-held GPS, Survey-grade GPS
<u>Mize</u> <u>MS</u> <u>39116</u> City State Zip Code	<u>NW 1/4 NE 1/4 Sec 18 Twn 1N Rng 7E</u>
Telephone No. <u>(601) 733-5384</u>	Distance Direction Nearest Town <u>5 Miles NW of MIZE</u>

Pump Type Circle one	Power Type Circle one
Air Lift Jet <input type="radio"/> <u>Submersible</u>	Diesel Engine Gasoline Engine Natural Gas
Bucket Piston <input type="radio"/> Turbine <input type="radio"/>	<u>Electric Motor</u> Hand Tractor PTO
Centrifugal Rotary <input type="radio"/> Flowing Well <input type="radio"/>	Windmill Other (specify): _____
Other (specify): _____	Horse Power Rating of Motor: <u>1</u>
Date Pump Installed: <u>8-20-08</u>	Setting Depth: <u>140</u> feet
Rated Pump Capacity: <u>19</u> Gallons Per Minute	Number of Stages: _____

Pump Test Data	Method of Measuring Water Level Circle one
Date Well Tested: _____	Air Line Electric Measuring Line Steel Tape
Static Water Level (A): _____ Feet Below Land Surface	Other (specify): _____
Pumping Water Level (B): _____ Feet Below Land Surface	For flowing well, measured shut in head: _____ feet
Drawdown [(B) - (A)]: _____ Feet Below Land Surface	Well yielded _____ GPM with a drawdown of _____ feet after _____ hours of pumping
Test Pumping Rate: _____ Gallons Per Minute	
Duration of Pump Test (minimum 4 hours): _____ hours	

I HEREBY CERTIFY that the above statements are true to the best of my knowledge.
David West 0-692 David West RECEIVED
 Print Name of Pump Installer and License No. (if applicable) Signature of Pump Installer

SEP 18 2008
 BY: OLWR