

SMITH

M 2000
5-5-78

MISSISSIPPI
BOARD OF WATER COMMISSIONERS
416 North State Street
Jackson, Mississippi 39201

WATER WELL DRILLERS LOG

5-5 date well completed 78 Wk. Barnett W. Smith Co. firm name Smith Co. county well located

LANDOWNER: J. D. Johnson

description of formations encountered

from

to

RT. 1
Wagee MS.
(mailing address)

Red Clay	0	15
Yellowed Clay	15	21
Fine Sand	21	40
Course Sand	40	68
Blue Clay	68	91
Fine Blue Sand	91	150
Water Sand	150	187

WELL LOCATION:

sec. 8 T. 1 N. 7 E. R. 1 D. E. W. C.
0.5 miles N.W. of Wagee

WELL PURPOSE: Chicken House
(home, irrigation, municipal, industrial)

WELL COMPLETION DATA:

- (1) diameter (inches) 2
- (2) total depth (feet) 187
- (3) static water level (feet) 58 below top of ground.
- (4) casing Galv. (material), (depth)
- 2 (size) If telescope see back.
- (5) screen 5' (length), (depth to top)
- 00 (size), 3.5" (material)
- (6) pump 1-HP (HP), 70 (yield gpm)
- Elec. (type power)
- (7) electric log No (yes or no)
- (organization running log)
- (8) how well bottom plugged Wash Valve

RECEIVED


JUN 6 1978

MISS. BD. OF WATER COMM

DRILLERS REMARKS:

If well telescopes please sketch and show depths.

GROUND LEVEL

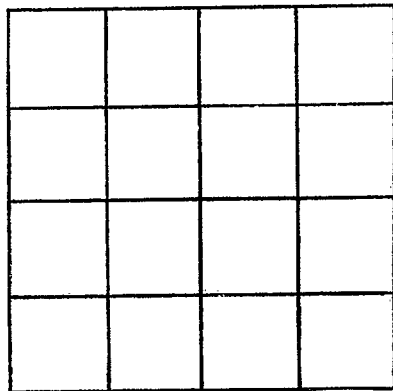

SECTION _____

Please indicate well location X.

ADDITIONAL INFORMATION

If more than one screen, show locations of each on sketch.