

SMITH

M 2001

9-26-78

MISSISSIPPI  
 BOARD OF WATER COMMISSIONERS  
 416 North State Street  
 Jackson, Mississippi 39201

WATER WELL DRILLERS LOG

SMITH

9-26

1978 W.K. Barnes

~~Jasper~~  
~~Jasper~~

date well completed

firm name

county well located

LANDOWNER:

Zeke you

description of formations encountered

from

to

Rt. 1  
Mayer  
(mailing address)

Red clay  
Blue clay  
Blue sand  
Blue clay  
Course sand

0 10  
10 52  
52 59  
59 68  
68 86

WELL LOCATION:

sec. 1 T. 1 N. R. 16 E.  
10 miles N-W of Miss  
(distance) (direction) (nearest town)

WELL PURPOSE:

Home  
(home, irrigation, municipal, industrial)

WELL COMPLETION DATA:

- (1) diameter (inches) 2
- (2) total depth (feet) 86
- (3) static water level (feet) 12 below above top of ground.
- (4) casing Galv. 84  
(material) (depth)
- 06 if telescope see back.  
(size)
- (5) screen 4'  
(length) (depth to top)  
Stainless S.  
(size) (material)
- (6) pump L-H-P 8  
(HP) (yield gpm)  
Elec  
(type power)
- (7) electric log no  
(yes or no)  
none  
(organization running log)
- (8) how well bottom plugged Wash W.

DRILLERS REMARKS:


RECEIVED

OCT 10 1978

MISS. BD. OF WATER COMM

If well telescopes please sketch and show depths.

GROUND LEVEL

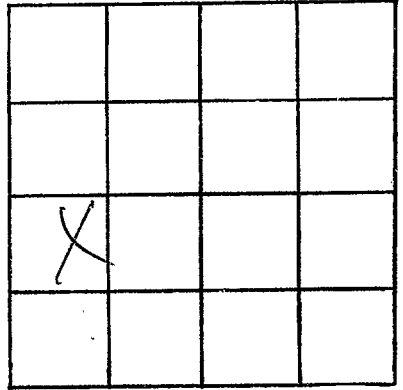

SECTION 1

Please indicate well location X.

ADDITIONAL INFORMATION

If more than one screen,  
show locations of each on sketch.