

Smith  
M  
8-29-79  
8-29

MISSISSIPPI  
BOARD OF WATER COMMISSIONERS  
416 North State Street  
Jackson, Mississippi 39201

WATER WELL DRILLERS LOG

1979 Ray West Water Wells Smith  
date well completed firm name county well located

LANDOWNER: Batha Engine  
Blakeney  
Rt 1 Mize  
(mailing address)

description of formations encountered	from	to
<u>red clay</u>	<u>0</u>	<u>15</u>
<u>poorly clay</u>	<u>15</u>	<u>35</u>
<u>soft lime stone</u>	<u>35</u>	<u>90</u>
<u>Blue clay</u>	<u>90</u>	<u>190</u>
<u>sand</u>	<u>190</u>	<u>226</u>

WELL LOCATION:  
sec. 14 T 1 N R 7 E  
7 miles 7 N of Mize  
(distance) (direction) (nearest town)

WELL PURPOSE: Home  
(home, irrigation, municipal, industrial)

- WELL COMPLETION DATA:
- (1) diameter (inches) 2
  - (2) total depth (feet) 226
  - (3) static water level (feet) 110 <sup>below</sup>/<sub>above</sub> top of ground.
  - (4) casing PVC 220  
(material) (depth)  
(size) if telescope see back.
  - (5) screen 6 220  
(length) (depth to top)  
1 1/4 steel  
(size) (material)
  - (6) pump 1 1/2 6  
(HP) (yield gpm)  
Rea  
(type power)
  - (7) electric log No  
(yes or no)

(organization running log)  
(8) how well bottom plugged Washed

DRILLERS REMARKS:


DEPT. OF NATURAL RESOURCES  
BUREAU OF LAND & WATER RESOURCES

OCT 9 1979

RECEIVED

If well telescopes please sketch and show depths.

GROUND LEVEL

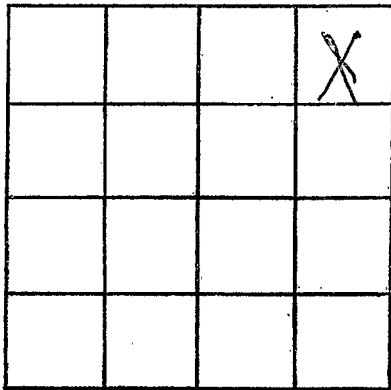

SECTION 14

Please indicate well location X.

ADDITIONAL INFORMATION

If more than one screen, show locations of each on sketch.