

MISSISSIPPI DEPARTMENT OF NATURAL RESOURCES

Bureau of Land and Water Resources

Southport Mall

P.O. Box 10631

Jackson, Mississippi 39209

WATER WELL DRILLERS LOG

Smith
M 0003

12-19 1984 Roy L. West Drlg Smith
 date well completed firm name county well located

LANDOWNER:
Paul Cockrell
Mize MS
 (mailing address)


description of formations encountered	from	to
SANDY CLAY	0	4
CLAY	4	68
SAND	68	72
CLAY	72	112
SAND	112	138

WELL LOCATION:
 sec 19 T 1 N R 7 E
4 miles NW of MIZE
 (distance) (direction) (nearest town)

WELL PURPOSE: Ch. of Can. Home
 (home, irrigation, municipal, industrial)

- WELL COMPLETION DATA:
- (1) diameter (inches) 4"
 - (2) total depth (feet) 138'
 - (3) static water level (feet) 36' below above top of ground.
 - (4) casing PVC, 128'
 (material) (depth)
4" if telescope see back.
 (size)
 - (5) screen 10', 128'
 (length) (depth to top)
4", PVC
 (size) (material)
 - (6) pump 1, 33
 (HP) (yield gpm)
REA
 (type power)
 - (7) electric log NO
 (yes or no)
 (organization running log)
 - (8) how well bottom plugged:
W ASPHALT CEMENT


DRILLERS REMARKS:

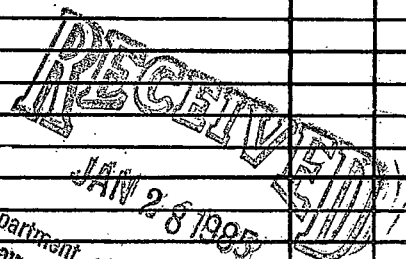

Department of Natural Resources
 Bureau of Land & Water

If well telescopes please sketch and show depths.

GROUND LEVEL

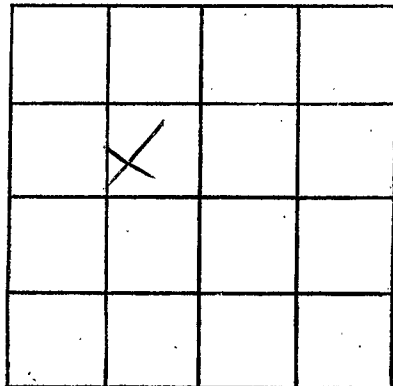

SECTION 19

Please indicate well location X.

ADDITIONAL INFORMATION

If more than one screen,
show locations of each on sketch.