

MISSISSIPPI DEPARTMENT OF NATURAL RESOURCES

Bureau of Land and Water Resources

Southport Mall

P.O. Box 10631

Jackson, Mississippi 39209

WATER WELL DRILLERS LOG

Smith
M 2004

12-19 1984 Roy V. West Dalg Smith
date well completed firm name county well located

LANDOWNER: L.O. White
Mize MS
(mailing address)

description of formations encountered	from	to
<u>CLAY</u>	<u>0</u>	<u>8</u>
<u>SAND</u>	<u>8</u>	<u>11</u>
<u>CLAY</u>	<u>11</u>	<u>160</u>
<u>SAND</u>	<u>160</u>	<u>206</u>

WELL LOCATION: 8
sec 25 T 1 N 5 R 10 E
4 miles W of MIZE
(distance) (direction) (nearest town)

WELL PURPOSE: Chicken House
(home, irrigation, municipal, industrial)


- WELL COMPLETION DATA:
- (1) diameter (inches) 2"
 - (2) total depth (feet) 206'
 - (3) static water level (feet) 0' below above top of ground.
 - (4) casing PVC 201'
(material) (depth)
2" if telescope see back.
(size)
 - (5) screen 5' 201'
(length) (depth to top)
2" PVC
(size) (material)
 - (6) pump 1 8
(HP) (yield gpm)
REA
(type power)
 - (7) electric log no
(yes or no)
(organization running log)
 - (8) how well bottom plugged W 75% UNPLUG

DRILLERS REMARKS:

REGISTERED
JAN 28 1985
Department of Natural Resources
Bureau of Land & Water Resources

If well telescopes please sketch and show depths.

GROUND LEVEL

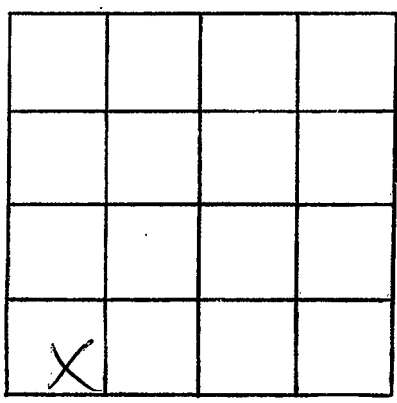

SECTION 25

Please indicate well location X.

ADDITIONAL INFORMATION

A series of horizontal lines for writing additional information.

If more than one screen, show locations of each on sketch.