

MISSISSIPPI DEPARTMENT OF NATURAL RESOURCES

Bureau of Land and Water Resources

Southport Mall

P.O. Box 10631

Jackson, Mississippi 39209

WATER WELL DRILLERS LOG

Smith
M 2000

9-9
date well completed

1987 Ray V. West
firm name

Smith
county well located

LANDOWNER:
Frank Landram
Magee MS
(mailing address)

description of formations encountered	from	to
CLAY	0	14
SAND	14	26
CLAY	26	81
SAND	81	101

WELL LOCATION:
sec 20 T 1 N R 16 E 7
S W
5 miles NW of MIZE
(distance) (direction) (nearest town)

WELL PURPOSE: CHICKEN HOUSE
(home, irrigation, municipal, industrial)

- WELL COMPLETION DATA:
- (1) diameter (inches) 4"
 - (2) total depth (feet) 101'
 - (3) static water level (feet) 13' below top of ground.
 - (4) casing (material) PVC (depth) 91'
4" (size) if telescope see back.
 - (5) screen 10' (length) 91' (depth to top)
4" (size) PVC (material)
 - (6) pump 1 (HP) 35 (yield gpm)
REA (type power)
 - (7) electric log no (yes or no)
(organization running log)
 - (8) how well bottom plugged WASH VALVE


RECEIVED
NOV 04 1987

DRILLERS REMARKS:

Department of Natural Resources
Bureau of Land & Water Resources

If well telescopes please sketch and show depths.

GROUND LEVEL

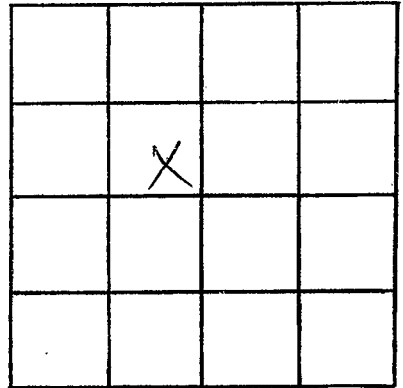

SECTION 20

Please indicate well location X.

ADDITIONAL INFORMATION

If more than one screen, show locations of each on sketch.