

SMITH

MISSISSIPPI BOARD OF WATER COMMISSIONERS

3 N 1

Sch...

0  
# 74

6-18-62

WATER WELL DRILLERS LOG

Date: 6/18

1962

Driller:

Wayne White  
(Name)

County

Smith

(1) Owner of Land: J & nephew

(Name)

Miss

(Address)

(2) Location: Center 1/4, Sec. 30 T. 1 R. 15

5 miles N of Miss  
(distance) (direction) (Nearest Town)

(3) Topography: x  
(Hilly) (Flat) (Level)

(4) Purpose of Well: Domestic  
(Domestic Irrigation, Municipal, Industrial, Other)

Information upon completion of well:

(1) Diameter 2 inches.

(2) Total Depth 125 feet.

(3) Water Level 115 feet below top of ground.

(4) Cased to 120, Size 2"

(5) Screen: Size 1/4, Length 5 ft

(6) Were any formations sealed against pollution?

yes, no.

If YES depth of formation

Why

Plastic pipe with

Drillers Remarks:

For 1 dot pump  
Soft 1 hp

Description & Color of Materials  
Sand, Clay, Red Clay, Shell, etc.

Thick-  
ness  
Feet

Depth  
Feet

Red Clay

20 20



Sand

95 115

Water Sand

15 125

12 ft. 2  
12 ft. 5  
12 ft. 50

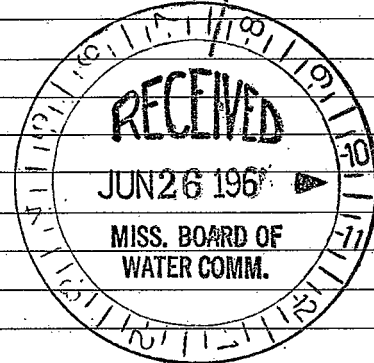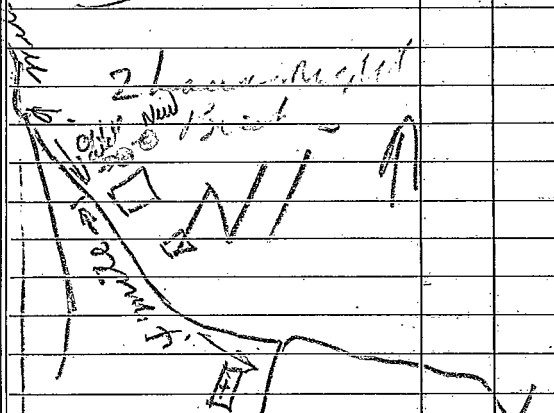

(Use Back Side)

Well No.

