

SMITH

MISSISSIPPI BOARD OF WATER COMMISSIONERS

3 N 2
10-12-62

WATER WELL DRILLERS LOG

Date: 10/12, 1962, Driller: C.P. Clark County Smith

Byron H. Baird Sr (Name)

(1) Owner of Land:	Description & Color of Materials Sand, Clay, Red Clay, Shell, etc.	Thick- ness Feet	Depth Feet
Carl Smith (Name)	0-80 Clay	80	
Rt #1 Taylorsville Miss (Address)	80-91 fine sand	11	
NE 1/4, NE 1/4, Sec. 26 T. 1 N. 9 E. (Location)	91-176 Blue Clay	79	
4 miles North of Taylorsville (distance) (direction) (Nearest Town)	170-340 Clay rocks	170	
Topography: <input checked="" type="checkbox"/> (Hilly) <input type="checkbox"/> (Flat) <input type="checkbox"/> (Level)	340-365 fine sand	35	
Purpose of Well: Chicken House (Domestic Irrigation, Municipal, Industrial, Other)			


Information upon completion of well:

- (1) Diameter 2 inches.
- (2) Total Depth 365 feet.
- (3) Water Level 35 feet below top of ground.
- (4) Cased to 343, Size 2 in.
- (5) Screen: Size 1 1/4, Length 22.
- (6) Were any formations sealed against pollution?
 yes, no.

If YES depth of formation 300

Why

Drillers Remarks: Seal Clay
& fine Sand from above
No Skin

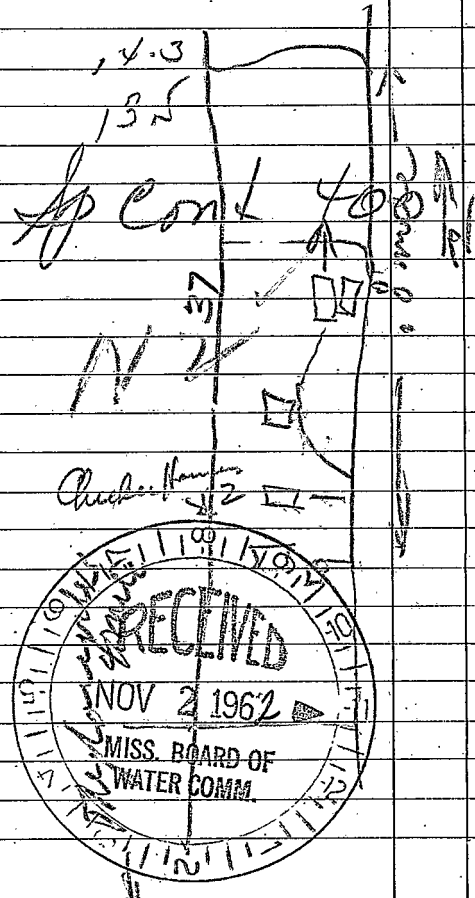

(Use Back Side)

Well No.

