

SMITH

N<sup>3</sup>

11-29-60

WATER WELL DRILLERS LOG

N-301

Date: 11/29, 1960, Driller: James H. Smith County: Smith

(Name)

(1) Owner of Land: W.M. Hayes  
(Name)  
Miss. Road  
(Address)

(2) Location: 9E 1/4, S31 1/4, Sec. 7 T. 1 R. 8  
5 miles E. So. of Calais  
(distance) (direction) (Nearest Town)

(3) Topography: X  
(Hilly) (Flat) (Level)

(4) Purpose of Well: Domestic  
(Domestic Irrigation  
Municipal, Industrial, Other)

Description & Color of Materials Sand, Clay, Red Clay, Shell, etc.	Thick-ness Feet	Depth Feet
<u>Red Clay</u>	<u>10</u>	<u>10</u>
<u>Sand</u>	<u>45</u>	<u>55</u>
<u>Water Level</u>	<u>55</u>	<u>55</u>

Information upon completion of well:

(1) Diameter 2 inches.

(2) Total Depth 73 feet.

(3) Water Level 55 feet below top of ground.

(4) Cased to 67, Size 2"


(5) Screen: Size 1/2", Length 6 ft.

(6) Were any formations sealed against pollution?  
\_\_\_\_\_ yes, \_\_\_\_\_ no.

If YES depth of formation \_\_\_\_\_

Why \_\_\_\_\_

Drillers Remarks: \_\_\_\_\_

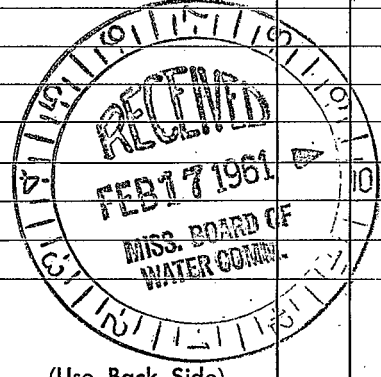

(Use Back Side)

Well No.

1000

1000

