

SMITH

MISSISSIPPI BOARD OF WATER COMMISSIONERS

3 NS
5-1-61

WATER WELL DRILLERS LOG

71 303

Date: 5/1, 1961, Driller: J A White County: Smith

(Name)

(1) Owner of Land: M.C. Kennedy
(Name)
Rt 2nd main
(Address)

Description & Color of Materials
Sand, Clay, Red Clay, Shell, etc.

Thick-
ness
Feet

Depth
Feet

Red clay
Sand
water sand

18 18
47 65
14 79

(2) Location: NE 1/4, NE 1/4, Sec. 6 T1 R8,
South 5 miles, of Raleigh
(distance) (direction) (Nearest Town)

(3) Topography: X
(Hilly) (Flat) (Level)

(4) Purpose of Well:
(Domestic Irrigation
Municipal, Industrial, Other)

Information upon completion of well:

(1) Diameter 2" inches.

(2) Total Depth 79 feet.

(3) Water Level 65 feet below top of ground.

(4) Cased to 75, Size 2"


(5) Screen: Size 1 1/4", Length 5'

(6) Were any formations sealed against pollution?
yes, no.

If YES depth of formation

Why

Drillers Remarks:

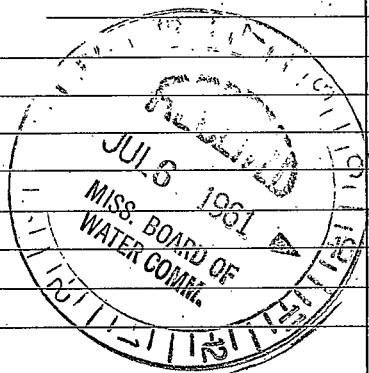

(Use Back Side)

Well No.

Frank

10

11

10 20
10 10
10 10

10 10 10 10

10 10 10 10

10 10

10 10

10 10

10

10 10

10

10

