

WATER WELL DRILLERS LOG

3 N 6
6-15-61

0 N 304

Date: 6/15, 1961, Driller: James A. Redick County: Smith

(Name)

(1) Owner of Land: G.S. Gomer
(Name)

Logansville Ga
(Address)

(2) Location: NE 1/4, SW 1/4, Sec 10 T1 R8

1 miles SE of Center Ridge
(distance) (direction) (Nearest Town)

(3) Topography: (Hilly) (Flat) (Level)

(4) Purpose of Well: Domestic
(Domestic Irrigation
Municipal, Industrial, Other)

Information upon completion of well:

(1) Diameter 2 inches.

(2) Total Depth 74 feet.

(3) Water Level 58 feet below top of ground.

(4) Cased to 64, Size 3"

(5) Screen: Size 1 1/4, Length 12'

(6) Were any formations sealed against pollution?
_____ yes, _____ no.

If YES depth of formation _____

Why _____

Drillers Remarks: _____

Description & Color of Materials
Sand, Clay, Red Clay, Shell, etc.

Thick-
ness
Feet


Depth
Feet

red clay 16 15

1 band 30 15

white chalk 12 58

residual sand 16 74

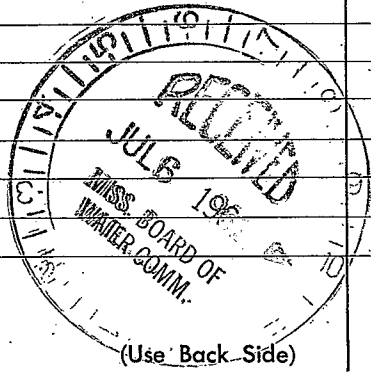

Well No.

Handwritten text, mostly illegible due to extreme contrast and noise. Some faint words like "page 5" are visible on the right side.