

SMITH
6N7
4-16-62
#74

MISSISSIPPI BOARD OF WATER COMMISSIONERS

WATER WELL DRILLERS LOG

0

Date: 4/16, 1962, Driller: Wayne White County Smith
(Name)


(1) Owner of Land:	Description & Color of Materials Sand, Clay, Red Clay, Shell, etc.	Thick- ness Feet	Depth Feet
<u>V.T. Allen</u> (Name)	<u>Red Clay</u>	<u>20</u>	<u>20</u>
<u>Mt. Airy Pt and</u> (Address)	<u>Sand</u>	<u>35</u>	<u>55</u>
(2) Location: <u>1/4</u> , <u>1/4</u> , Sec. <u>16</u> T <u>10</u> R <u>16</u>	<u>water sand</u>	<u>12</u>	<u>67</u>
<u>5</u> miles <u>N.E.</u> , of <u>Miss</u> (distance) (direction) (Nearest Town)			
(3) Topography: <input checked="" type="checkbox"/> (Hilly) <input type="checkbox"/> (Flat) <input type="checkbox"/> (Level)			
(4) Purpose of Well: <u>Domestic</u> (Domestic Irrigation, Municipal, Industrial, Other)			

Information upon completion of well:

- (1) Diameter 2 inches.
- (2) Total Depth 67 feet.
- (3) Water Level 6-5 feet below top of ground.
- (4) Cased to 62, Size 2"
- (5) Screen: Size 1/4, Length 5 ft
- (6) Were any formations sealed against pollution?
_____ yes, _____ no.

If YES depth of formation _____
Why _____

Drillers Remarks: _____

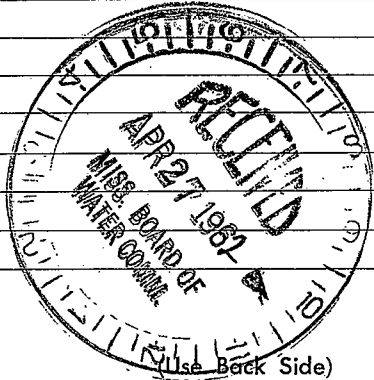

Well No. _____

