

SMITH
6 N 8

MISSISSIPPI BOARD OF WATER COMMISSIONERS

76

6-19-62

WATER WELL DRILLERS LOG

Date: 6/19, 1962, Driller: royal white County Smith
(Name)

(1) Owner of Land: AS Hinboat
(Name)
Rt 2 Forrest, Miss
(Address)

(2) Location: 1/4, 1/4, Sec. 6 T 3 R 8,
7 miles S, of Relief
(distance) (direction) (Nearest Town)

(3) Topography: y
(Hilly) (Flat) (Level)

(4) Purpose of Well: Domestic
(Domestic Irrigation
Municipal, Industrial, Other)

Description & Color of Materials Sand, Clay, Red Clay, Shell, etc.	Thick- ness Feet	Depth Feet
<u>Red clay</u>	<u>20</u>	<u>20</u>
<u>Sand</u>	<u>10</u>	<u>30</u>
<u>water sand</u>	<u>12</u>	<u>42</u>


Information upon completion of well:

- (1) Diameter 2" inches.
- (2) Total Depth 42 feet.
- (3) Water Level 30 feet below top of ground.
- (4) Cased to 34, Size 2"
- (5) Screen: Size 1/4, Length 6 ft
- (6) Were any formations sealed against pollution?
_____ yes, _____ no.

If YES depth of formation _____

Why _____

Drillers Remarks: _____

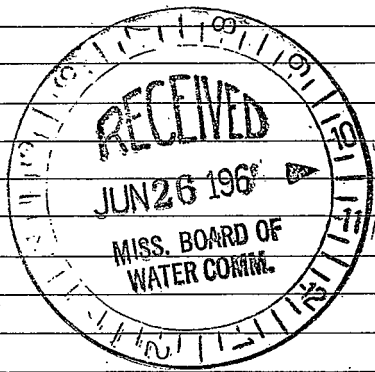

(Use Back Side)

Well No.

