

SMITH
N 9
9-7-62

MISSISSIPPI BOARD OF WATER COMMISSIONERS

WATER WELL DRILLERS LOG

Date: 9/7, 1962, Driller: Wayne White County Smith
(Name)


(1) Owner of Land:	Description & Color of Materials Sand, Clay, Red Clay, Shell, etc.	Thick- ness Feet	Depth Feet
<u>J. J. Johnson</u> (Name) <u>Waycross, Miss</u> (Address)	<u>Red Clay</u>	<u>50</u>	<u>20</u>
(2) Location: _____ 1/4, _____ 1/4, Sec. <u>10</u> T. <u>1</u> R. <u>8</u>	<u>Sand</u>	<u>10</u>	<u>30</u>
<u>1</u> miles <u>SE</u> of <u>Centerville</u> (distance) (direction) (Nearest Town)	<u>Chalk</u>	<u>20</u>	<u>50</u>
(3) Topography: <input checked="" type="checkbox"/> (Hilly) <input type="checkbox"/> (Flat) <input type="checkbox"/> (Level)	<u>Sand</u>	<u>6</u>	<u>56</u>
(4) Purpose of Well: <u>Domestic</u> (Domestic Irrigation Municipal, Industrial, Other)	<u>Chalk</u>	<u>2</u>	<u>58</u>
	<u>Sand</u>	<u>18</u>	<u>68</u>

Information upon completion of well:

- (1) Diameter 2" inches.
- (2) Total Depth 68 feet.
- (3) Water Level 58 feet below top of ground.
- (4) Cased to 60, Size 2"
- (5) Screen: Size 1/4, Length 8
- (6) Were any formations sealed against pollution?
_____ yes, _____ no.

If YES depth of formation _____
Why _____

Drillers Remarks: _____

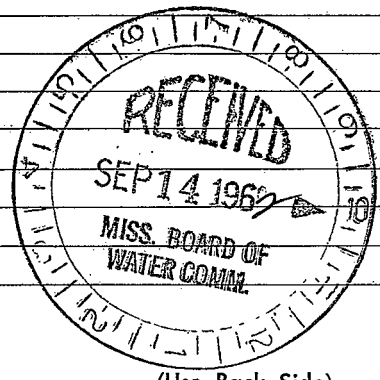

Well No.

