

SMITH  
N 13  
11-4-70

MISSISSIPPI  
BOARD OF WATER COMMISSIONERS  
416 North State Street  
Jackson, Mississippi 39201

**CODED**

WATER WELL DRILLERS LOG

11/14 1970 JR Parker water well Dr. Linneth  
date well completed firm name county well located

LANDOWNER: James Craft  
Rt 1 Mize  
(mailing address)

description of formations encountered	from	to
chalk	0	30
Red Sand	30	50
Carse white sand	50	90

WELL LOCATION:  
sec. 33 T-1 N R-8 E  
S W  
5 1/2 miles N/W of Taylorville  
(distance) (direction) (nearest town)

WELL PURPOSE: Home  
(home, irrigation, municipal, industrial)

- WELL COMPLETION DATA:
- (1) diameter (inches) 4"
  - (2) total depth (feet) 90'
  - (3) static water level (feet) 20' <sup>below</sup> above top of ground.
  - (4) casing PVC 75"  
(material) (depth)  
(size) if telescope see back.
  - (5) screen 5 ft 80"  
(length) (depth to top)  
2" PVC  
(size) (material)
  - (6) pump 1/2 6  
(HP) (yield gpm)  
JET  
(type power)
  - (7) electric log \_\_\_\_\_  
(yes or no)  
(organization running log)
  - (8) how well bottom plugged chalk

**CODED**

NOV 9 - 1970


MISS. BD. OF  
WATER COMM.

DRILLERS REMARKS:

If well telescopes please sketch and show depths.

GROUND LEVEL

R8E

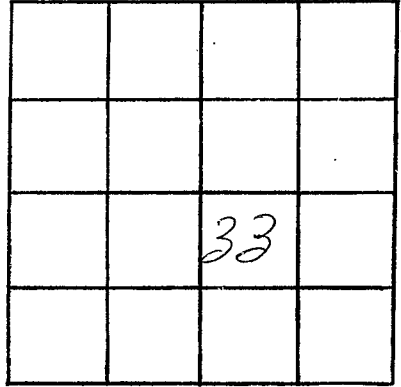

SECTION 33

Please indicate well location X.

ADDITIONAL INFORMATION

Go 4 mi. North of T1N  
on 37 take first  
left go 1 1/2 miles  
3 houses on left

If more than one screen,  
show locations of each on sketch.