

SMITH
N 14
10-1-70

MISSISSIPPI
BOARD OF WATER COMMISSIONERS
416 North State Street
Jackson, Mississippi 39201

CODED

WATER WELL DRILLERS LOG

10-1-70 date well completed 1970 W.K. Barnes Water Wells firm name Smith county well located

LANDOWNER: Central Oil Co.
Lane Spunk unit
Jallahabie Creek
(mailing address)

WELL LOCATION:
sec. 24 T. 1 N. R. 14 E. S. 5
4 miles S of Sylvers
(distance) (direction) (nearest town)

WELL PURPOSE: Waters for
(home, irrigation, municipal, industrial)

WELL COMPLETION DATA:
(1) diameter (inches) 2
(2) total depth (feet) 196
(3) static water level (feet) 145 below above top of ground.
(4) casing 2" (material) 5' galv. m. (depth)
2" (size) if telescope see back.
(5) screen 4' (length) (depth to top)
0.6 Slot Stainless Steel (size) (material)
(6) pump 3/4 (HP) 15 (yield gpm)
Elec (type power)
(7) electric log NO (yes or no)
(organization running log)
(8) how well bottom plugged Washed

description of fomations encountered	from	to
Red clay	0	5
yellow clay	5	8
Blue clay	8	35
Course sand	35	46
Blue clay	46	84
Hard Rock	84	92
Blue clay	92	100
Hard Rock	100	128
Blue clay	128	134
Rock	134	138
Blue clay	138	149
Fine sand	149	196

CODED


NOV 18 1970

MISS. BD. OF WATER COMMISSIONERS

DRILLERS REMARKS:

If well telescopes please sketch and show depths.

GROUND LEVEL

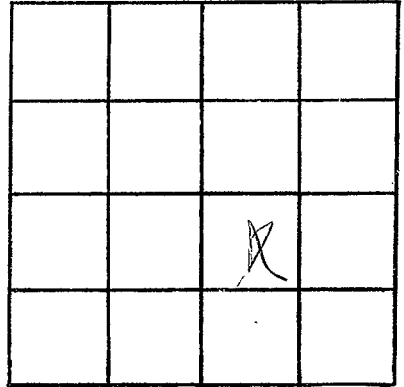

SECTION 24

Please indicate well location X.

ADDITIONAL INFORMATION

If more than one screen,
show locations of each on sketch.