

SMITH
N 16
5-18-71

MISSISSIPPI
BOARD OF WATER COMMISSIONERS
416 North State Street
Jackson, Mississippi 39201

CODED

WATER WELL DRILLERS LOG

5/18/71 date well completed 1971 J.P. Parker Water Well Drilling Smith firm name county well located

LANDOWNER: Larry Strickling
RT. 3 Tylarville
(mailing address)
WELL LOCATION: 8(E)
sec 25 T-14N R-10E
5 miles north of Tylarville
(distance) (direction) (nearest town)

description of formations encountered	from	to
chack	0	20
sand	20	30
Blue chack	30	140
Rock	140	144
chack	144	160
Rock	160	161
Soft chack	161	200
Water Sand	200	220

WELL PURPOSE: HOME
(home, irrigation, municipal, industrial)

WELL COMPLETION DATA:
(1) diameter (inches) 2"
(2) total depth (feet) 220 ft.
(3) static water level (feet) 60 ^{below}/_{above} top of ground.
(4) casing galv. 2 1/2" (material), 212 (depth), 1 1/4" (size) if telescope see back.
(5) screen 8 ft., 220 ft. (length), (depth to top), 1 1/4" (size), S/S (material)
(6) pump 1 (HP), 6 (yield gpm), 90T (type power)
(7) electric log (yes or no)
(organization running log)
(8) how well bottom plugged chack

CODED

MAY 24 1971

MISS. DD. OF
WATER COMM.

DRILLERS REMARKS:

If well telescopes please sketch and show depths.


GROUND LEVEL

105 ft. 2 in

107 ft. 1/4 in

If more than one screen, show locations of each on sketch.

8 ft. screen

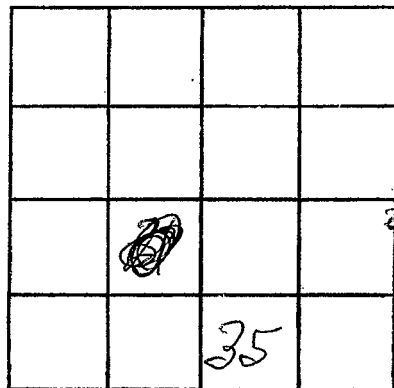

11. 8 W

SECTION 35

Please indicate well location X.

ADDITIONAL INFORMATION

go back of Taylorville
to Mt Zion Church
left on left