

SMITH
N 18
11-10-72

MISSISSIPPI
BOARD OF WATER COMMISSIONERS
416 North State Street
Jackson, Mississippi 39201

WATER WELL DRILLERS LOG

11/10/72 19 J.R. Parkes Water Well Smith
date well completed firm name county well located

LANDOWNER: Henry Loney
RT. 1
Taylorville Miss
(mailing address)

description of formations encountered	from	to
<u>Red sand</u>	<u>0</u>	<u>20</u>
<u>clay</u>	<u>20</u>	<u>55</u>
<u>water level</u>	<u>55</u>	<u>75</u>

WELL LOCATION:
sec. 21 T. 10 N. R. 3 E
6 miles North of Taylorville
(distance) (direction) (nearest town)

WELL PURPOSE: HOME
(home, irrigation, municipal, industrial)

- WELL COMPLETION DATA:
- (1) diameter (inches) 2"
 - (2) total depth (feet) 75
 - (3) static water level (feet) 30 below top of ground. above
 - (4) casing PVC 70
(material) (depth)
(size) If telescope see back.
 - (5) screen 5" 75
(length) (depth to top)
2" PVC
(size) (material)
 - (6) pump 1/2 8
(HP) (yield gpm)
Ac
(type power)
 - (7) electric log (yes or no)
 - (organization running log)
 - (8) how well bottom plugged chalk


DRILLERS REMARKS:

NOV 15 1972
MISS. BD. OF WATER CONTROL

If well telescopes please sketch and show depths.

GROUND LEVEL

RSE

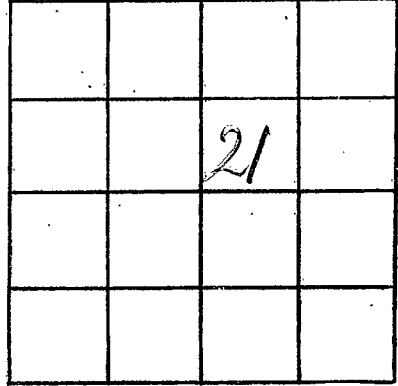

TIN

SECTION 21

Please indicate well location X.

ADDITIONAL INFORMATION

Handwritten notes:
1. 10' ...
2. 10' ...
3. 10' ...

If more than one screen, show locations of each on sketch.