

MISSISSIPPI DEPARTMENT OF NATURAL RESOURCES

Bureau of Land and Water Resources


Southport Mall

P.O. Box 10637

Jackson, Mississippi 39209

WATER WELL DRILLERS LOG

Griner Drilling Service, Inc.

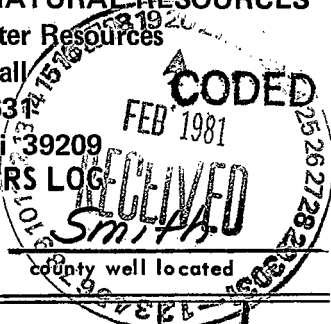

SMITH  
N 20  
2/6/81

date well completed

firm name

county well located

LANDOWNER:  
Transcontinental Oil Corp.  
1400 First National Bank Bldg.  
Shreveport, La. 71101  
(mailing address)

description of formations encountered

from

to

WELL LOCATION: 500' N & 500' W of  
No 1 sec 29 T 1 N R 8 S SE 1/4  
Ainsworth  
White miles Nize of (nearest town)

clay, rocks, sand	0	42
sand	42	84
sand, clay	84	126
clay, rock, sand	126	378
sand, some clay	378	392
clay, sand	392	441
sand, breakers clay	441	483
clay, some sand	483	651

WELL PURPOSE: oil field supply  
(home, irrigation, municipal, industrial)

WELL COMPLETION DATA:

- (1) diameter (inches) 4"
- (2) total depth (feet) 651'
- (3) static water level (feet) 75' <sup>below</sup> <sub>above</sub> top of ground.
- (4) casing steel, 483'  
(material) (depth)
- 4"  
(size) if telescope see back.
- (5) screen 42', 441'  
(length) (depth to top)
- 4", perforated  
(size) (material)
- (6) pump —, 80  
(HP) (yield gpm)
- AC  
(type power)
- (7) electric log —  
(yes or no)

DEPT. OF NATURAL RESOURCES  
BUREAU OF LAND & WATER RESOURCES

FEB 20 1981

RECEIVED


(organization running log)

(8) how well bottom plugged orange  
peel

DRILLERS REMARKS:

If well telescopes please sketch and show depths.

GROUND LEVEL

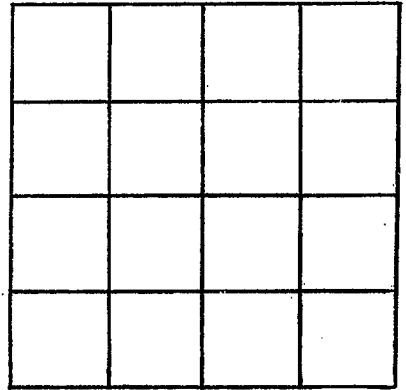

SECTION \_\_\_\_\_

Please indicate well location X.

ADDITIONAL INFORMATION

If more than one screen,  
show locations of each on sketch.