

MISSISSIPPI DEPARTMENT OF ENVIRONMENTAL QUALITY
Bureau of Land and Water Resources

P. O. Box 10631
Jackson, MS 39289-0631
WATER WELL DRILLERS LOG

COUNTY WELL LOCATED Smith	
WELL NUMBER N 24	CODED <input checked="" type="checkbox"/>
DATE WELL COMPLETED 12-10-90	

PERMIT NUMBER
NAME OF DRILLING FIRM Roy d. West

NAME & MAILING ADDRESS OF LANDOWNER Jimmy White		
P.O. Box 1418		
Collins MS 39428		
WELL LOCATION: SEC	TOWNSHIP	RANGE
28	1 N S	8 E W
DISTANCE	DIRECTION	NEAREST TOWN
S Miles	ENE E of	MIZE
OTHER LANDMARK		
WELL PURPOSE: Home, Irrigation, Municipal, Industrial, Fish Pond, etc. Poultry Farm		

PUMP DATA		
PUMP TYPE (Circle One): <u>Submersible</u> Turbine, Jet, Flowing Well, Other (Describe) _____		
POWER TYPE (Circle One): <u>Electric</u> , Tractor, Diesel, Gasoline, Butane, Other (Describe) _____ H/P 1		
Pump Capacity (GPM) 20	No. of Stages	Setting Depth 100 FT.
PUMP TEST		
Well yielded _____ GPM with a drawdown of _____ ft. after _____ hours of pumping		

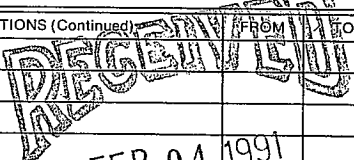
WELL DATA		
Well Depth 397	Casing Diameter (In.) 4"	Casing Length (Ft.) 377'
Type of Casing PVC	Hole Depth 397	Depth to Static Water Level 65'
TYPE OF COMPLETION: (Circle One or More): <u>Gravel Packed</u> , Underreamed, Telescoped, <u>Natural Development</u> , Open Hole, Other (Describe) _____		
Top of Lap Pipe or Reduction in Casing FEET IF TELESCOPED OR MORE THAN ONE SCREEN: USE BACK PAGE		

LOG DATA	
TYPE OF LOG RUN (Circle One): <u>Electric</u> Gamma Ray Density Sonic Neutron , Other (Describe) _____	
Name of Organization Running Log Bureau of Geology	

GEOLOGIC DATA (Office Use Only)			
Surface Elev.	Geologic Unit	Unit Thickness	Depth to Top
Subs. SWL	Date	Analysis	Aquifer Test

SCREEN DATA		
Diameter - Inches 4	Length - Feet 20	Slot Size - Inches .010
Screen Type PVC	Depth to Bottom - Feet 397	

Driller's Remarks

DESCRIPTION OF FORMATIONS ENCOUNTERED	FROM	TO	FORMATIONS (Continued)	FROM	TO
CLAY	0	26	 FEB 04 1991 Dept. of Environmental Quality Bureau of Land & Water Resources		
SAND	26	57			
CLAY with SAND	57	376			
STRS					
SAND	376	397			

IF MORE SPACE IS NEEDED, USE BACK

