

MISSISSIPPI DEPARTMENT OF NATURAL RESOURCES
Bureau of Land and Water Resources
 Southport Mall
 P.O. Box 10631
 Jackson, Mississippi 39209
WATER WELL DRILLERS LOG

SMITH
N2001
8/31/85

8-31 1985 ES Roy U. West Drilling Smith
 date well completed firm name county well located

LANDOWNER:
Bob Harrison
Taylorville MS
 (mailing address)

description of formations encountered	from	to
	<u>CLAY</u>	<u>0</u>
<u>SAND</u>	<u>12</u>	<u>130</u>

WELL LOCATION:
 sec. 30 T 1 N R. 130
5 miles NE of MIZE
 (distance) (direction) (nearest town)

WELL PURPOSE: Chicken House
 (home, irrigation, municipal, industrial)

- WELL COMPLETION DATA:**
- (1) diameter (inches) 2"
 - (2) total depth (feet) 130'
 - (3) static water level (feet) 90' below top of ground.
 - (4) casing PVC, 125'
 (material) (depth)
 (size) if telescope see back.
 - (5) screen 5', 125'
 (length) (depth to top)
2", PVC
 (size) (material)
 - (6) pump 1 1/2, 0
 (HP) (yield gpm)
REA
 (type power)
 - (7) electric log no
 (yes or no)
 (organization running log)
 - (8) how well bottom plugged WASHU ABOVE


DRILLERS REMARKS:

RECEIVED
 SEP - 9 1985

Department of Natural Resources
 Bureau of Land & Water Resources

If well telescopes please sketch and show depths.

GROUND LEVEL

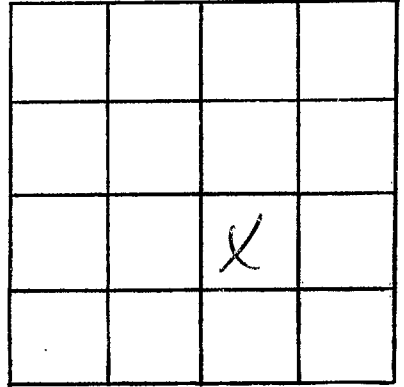

SECTION 86

Please indicate well location X.

ADDITIONAL INFORMATION

If more than one screen,
show locations of each on sketch.