

Smith
N 2002

MISSISSIPPI
BOARD OF WATER COMMISSIONERS
416 North State Street
Jackson, Mississippi 39201

WATER WELL DRILLERS LOG

Feb 12 1988 R-1 Drilling Service Smith
date well completed firm name county well located

LANDOWNER: J. G. Arnis
Rte 1, Box 702
Taylorsville, Ms 39168
(mailing address)

WELL LOCATION:
sec 12 T 1 N R 8 E
± 8 miles N of Taylorsville
(distance) (direction) (nearest town)

WELL PURPOSE: Home
(home, irrigation, municipal, industrial)

WELL COMPLETION DATA:
(1) diameter (inches) 2
(2) total depth (feet) 268'
(3) static water level (feet) 45' below top of ground.
(4) casing PVC 257'
(material) (depth)
(size) if telescope see back.
(5) screen 10' 257'
(length) (depth to top)
2" PVC slotted screen
(size) (material)
(6) pump 1
(HP) (yield gpm)
(type power)
(7) electric log no
(yes or no)

description of formations encountered	from	to
Top soil	0	1
Thin red clay	1	13
Sand & gravel	13	18
White clay	18	25
Gray clay	25	75
Sandy gray clay, fine sd	75	93
Gravel clay, lsid	93	162
Dark gray clay	162	207
Clay w/ sand streaks	207	213
Rock	213	214
White clay	214	219
Rock	219	219 1/2
White & gray limy clay	219 1/2	251
Sandy silty	251	266
Sandy clay	266	268
Clay	268	268 1/2

RECEIVED
FEB 22 1988

FEB 22 1988


Department of Natural Resources
Bureau of Land & Water Resources

ing log)
logged BWV
& steel shot

S:

If well telescopes please sketch and show depths.

GROUND LEVEL

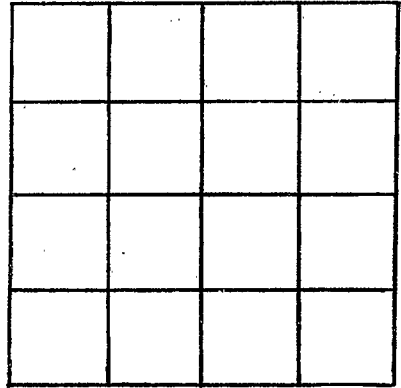

SECTION _____

Please indicate well location X.

ADDITIONAL INFORMATION

If more than one screen, show locations of each on sketch.