

CODED

MISSISSIPPI
BOARD OF WATER COMMISSIONERS
416 North State Street
Jackson, Mississippi 39201

WATER WELL DRILLERS LOG

CODED

Smith
03
8-27-68

8-27 date well completed 1968 W.K. Barnes water well Smith firm name county well located

LANDOWNER:
Bula DeJarnette
Jaylorsville Route 3
(mailing address)

description of formations encountered	from	to
Red Clay	0	10
Red sand	10	50
yellow clay	50	90
Fine sand	90	110
yellow clay	110	125
Rock	125	128
yellow clay	128	140
Water sand	140	173


WELL LOCATION: 9E
sec. 17 T. 1N R. 1E
S
0 miles Northw of Jaylorsville
(distance) (direction) (nearest town)

WELL PURPOSE: Home use
(home, irrigation, municipal, industrial)

WELL COMPLETION DATA:
(1) diameter (inches) 2
(2) total depth (feet) 173
(3) static water level (feet) 90 below above top of ground.
(4) casing Galv. 168
(material) (depth)
2" if telescope see back.
(size)
(5) screen 5'
(length) (depth to top)
7 Slot stainless steel
(size) (material)
(6) pump 1 1/2 4
(HP) (yield gpm)
Elco.
(type power)
(7) electric log no
(yes or no)
(organization running log)
(8) how well bottom plugged wash well

CODED

CODED

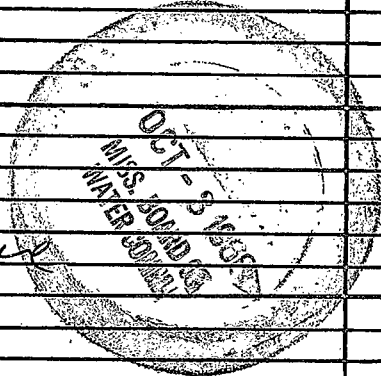

DRILLERS REMARKS:

If well telescopes please sketch and show depths.

GROUND LEVEL

			2

SECTION 17

Please indicate well location X.

ADDITIONAL INFORMATION

If more than one screen, show locations of each on sketch.