

4 130

31 5300 N 0892360 - 21
1988

TM CA

Smith
05
-64

MISSISSIPPI
BOARD OF WATER COMMISSIONERS
416 North State Street
Jackson, Mississippi 39201
WATER WELL DRILLERS LOG

Shoaty BS 1969 - Oct 11. Jek

1969 W. L. Barnes water wells Smith
date well completed firm name county well located

LANDOWNER: W. B. Yelverton

description of formations encountered

from to

Route 3
Jaylonsville Miss.
(mailing address)

description of formations encountered	from	to
<u>Red Clay</u>	<u>0</u>	<u>5</u>
<u>Red Sand</u>	<u>5</u>	<u>30</u>
<u>White Sand</u>	<u>30</u>	<u>55</u>
<u>yellow Clay</u>	<u>55</u>	<u>60</u>
<u>Sand</u>	<u>60</u>	<u>72</u>
<u>Rock</u>	<u>72</u>	<u>73</u>
<u>Blue Clay</u>	<u>73</u>	<u>130</u>
<u>Fine Sand</u>	<u>130</u>	<u>150</u>
<u>Water Sand</u>	<u>150</u>	<u>168</u>

CODED

WELL LOCATION:
sec. 32 T. 1 N. R. 9 E
S W
4 miles W E of Jaylonsville
(distance) (direction) (nearest town)

WELL PURPOSE: Home
(home, irrigation, municipal, industrial)

WELL COMPLETION DATA:


- (1) diameter (inches) 2
- (2) total depth (feet) 168
- (3) static water level (feet) 80 below above top of ground.
- (4) casing Plastic, 164,
(material) (depth)
- 0.75 inch if telescope see back.
(size)
- (5) screen Stainless Steel
(length) (depth to top)
- 2", Stainless Steel
(size) (material)
- (6) pump 1 1/2 10
(HP) (yield gpm)
- Elec.
(type power)
- (7) electric log _____
(yes or no)
- _____
(organization running log)
- (8) how well bottom plugged Wash Water

CODED

DRILLERS REMARKS:

If well telescopes please sketch and show depths.

GROUND LEVEL

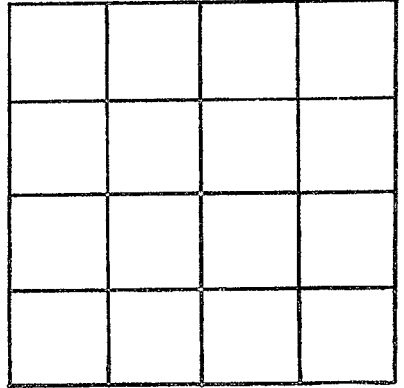

SECTION _____

Please indicate well location X.

ADDITIONAL INFORMATION

If more than one screen,
show locations of each on sketch.