

CODED

boxed

MISSISSIPPI
 BOARD OF WATER COMMISSIONERS
 416 North State Street
 Jackson, Mississippi 39201

CODED

WATER WELL DRILLERS LOG

Smith
06
11-22-68

11-22 1968 W.K. Barnes Water Well Service Smith
 date well completed firm name county well located

LANDOWNER:	description of formations encountered	from	to
<u>Mrs. Curtis Shelby</u>	<u>Red Clay</u>	<u>0</u>	<u>15</u>
<u>Route 3</u>	<u>Red sand</u>	<u>15</u>	<u>42</u>
<u>Jaylorsville, Miss</u>	<u>yellow clay</u>	<u>42</u>	<u>60</u>
(mailing address)	<u>Fine Sand</u>	<u>60</u>	<u>80</u>
WELL LOCATION:	<u>Coarse Sand and</u>	<u>80</u>	<u>109</u>
sec. <u>28</u> T <u>1</u> N <u>9</u>	<u>Sea Gravel</u>		
S <u>W</u> E <u>W</u>			
<u>4</u> miles <u>N.E.</u> of <u>Jaylorsville, Miss</u>			
(distance) (direction) (nearest town)			

WELL PURPOSE: Chicken House
 (home, irrigation, municipal, industrial)

WELL COMPLETION DATA:


- (1) diameter (inches) 2
- (2) total depth (feet) 109
- (3) static water level (feet) 102 below above top of ground.
- (4) casing Galv., 105
 (material) (depth)
2" if telescope see back.
 (size)
- (5) screen 4 ft., 105
 (length) (depth to top)
2", Stainless Steel
 (size) (material)
- (6) pump 1-H.P., 5
 (HP) (yield gpm)
Elec.
 (type power)
- (7) electric log no
 (yes or no)
 (organization running log)
- (8) how well bottom plugged wash valve

DRILLERS REMARKS:

DEC 15 1968
 MISS. DEPT. OF
 WATER CONTROL

If well telescopes please sketch and show depths.

GROUND LEVEL

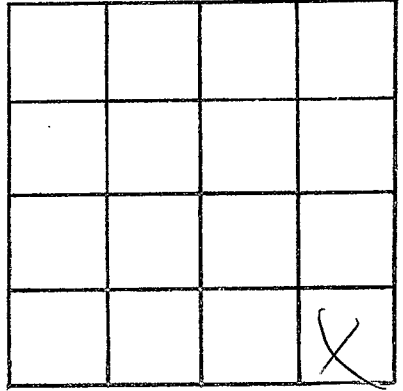

SECTION 28

Please indicate well location X.

ADDITIONAL INFORMATION

If more than one screen,
show locations of each on sketch.