

Smith
 07
 3-19-69

MISSISSIPPI
 BOARD OF WATER COMMISSIONERS
 416 North State Street
 Jackson, Mississippi 39201

CODED

WATER WELL DRILLERS LOG

Smith

3-19 1969 W. K. Barnes water well
 date well completed firm name county well located


LANDOWNER: <u>Bill Strang</u>	description of formations encountered	from	to
<u>Bay Springs</u> <u>Route 2</u> (mailing address)	<u>Red Clay</u> <u>Red Sand</u> <u>yellow clay</u> <u>water sand</u>	<u>0</u> <u>15</u> <u>40</u> <u>71-106</u>	<u>15</u> <u>100</u> <u>71</u> <u>6</u>
WELL LOCATION: <u>9</u> sec. <u>24</u> T- <u>1</u> (N) R- <u>13</u> (E) <u>8</u> miles <u>S</u> of <u>Bay Springs</u> (distance) (direction) (nearest town)			
WELL PURPOSE: <u>for pump</u> (home, irrigation, municipal, industrial)			
WELL COMPLETION DATA:			
(1) diameter (inches) <u>2</u>			
(2) total depth (feet) <u>106</u>			
(3) static water level (feet) <u>70</u> below top of ground.			
(4) casing <u>Galv.</u> (material) (depth) <u>2"</u> (size) if telescope see back.			
(5) screen <u>4'</u> (length) (depth to top) <u>8 slot, Stainless Steel</u> (size) (material)			
(6) pump <u>2</u> <u>10</u> (HP) (yield gpm) <u>Elec.</u> (type power)			
(7) electric log _____ (yes or no)			
_____ (organization running log)			
(8) how well bottom plugged <u>Wash</u>			
DRILLERS REMARKS:			

JUN 2 1969

MISS. BD. OF
 WATER COMM.

If well telescopes please sketch and show depths.

GROUND LEVEL

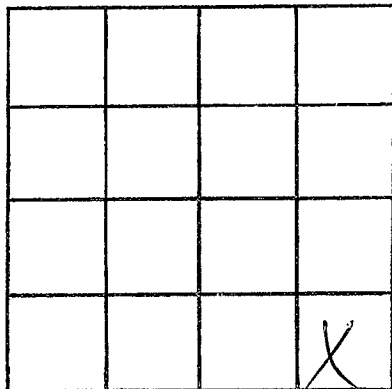

SECTION 24

Please indicate well location X.

ADDITIONAL INFORMATION

If more than one screen, show locations of each on sketch.