

CODED

MISSISSIPPI  
BOARD OF WATER COMMISSIONERS  
416 North State Street  
Jackson, Mississippi 39201

WATER WELL DRILLERS LOG

Smith  
DB  
8-22-69

8-22 date well completed    1969 W. K. Barnes waterworks Smith firm name    county well located

LANDOWNER: <u>Joe R. Stinger</u>	description of formations encountered	from	to
<u>Pt. 2</u>			
<u>Bay Springs Miss.</u> (mailing address)	<u>Red Clay</u>	<u>0</u>	<u>14</u>
	<u>Red Sand</u>	<u>14</u>	<u>30</u>
	<u>White Sand Arg.</u>	<u>30</u>	<u>54</u>
	<u>Yellow Clay</u>	<u>54</u>	<u>80</u>
	<u>Fine White Sand</u>	<u>80</u>	<u>96</u>
	<u>Coarse Sand</u>	<u>96</u>	<u>115</u>

WELL LOCATION:  
sec. 26 T. 1 N. R. 13 E.  
0 miles South of Bay Springs  
(distance) (direction) (nearest town)

WELL PURPOSE: Home use  
(home, irrigation, municipal, industrial)

- WELL COMPLETION DATA:
- (1) diameter (inches) 2
  - (2) total depth (feet) 115
  - (3) static water level (feet) 82 below above top of ground.
  - (4) casing Plastic (material), 110 (depth)  
2" If telescope see back. (size)
  - (5) screen 5' (length) (depth to top)  
3/8" Slit, Stainless S. (size) (material)
  - (6) pump 1 (HP) 8 (yield gpm)  
Elec. (type power)
  - (7) electric log no (yes or no)
- (organization running log)
- (8) how well bottom plugged Washed


OCT 29 1969

MISS. EP. 05  
WATER COMMISSION

DRILLERS REMARKS:

If well telescopes please sketch and show depths.

GROUND LEVEL

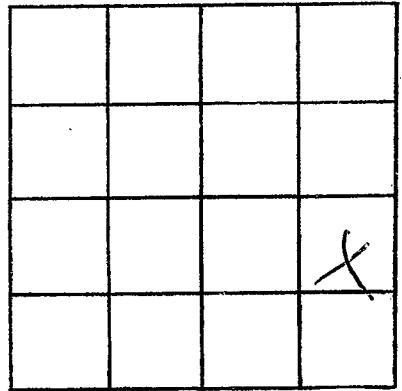

SECTION 26

Please indicate well location X.

ADDITIONAL INFORMATION

If more than one screen,  
show locations of each on sketch.