

Smith
09
9-8-69

MISSISSIPPI
 BOARD OF WATER COMMISSIONERS
 416 North State Street
 Jackson, Mississippi 39201

CODED

WATER WELL DRILLERS LOG

9-8 1969 W. K. Barnes Water wells Samit
 date well completed firm name county well located

LANDOWNER: <u>Cecil Brown</u>	description of formations encountered	from	to
<u>Bay Springs Miss.</u> <u>Route 2</u> (mailing address)			
WELL LOCATION: sec. <u>26 T 1 (N) S</u> R. <u>13 E</u> <u>9</u> miles <u>S.W.</u> of <u>Bay Springs Miss.</u> (distance) (direction) (nearest town)	<u>Red Clay</u>	<u>0</u>	<u>14</u>
	<u>Red sand</u>	<u>14</u>	<u>26</u>
	<u>white Dry Sand</u>	<u>26</u>	<u>40</u>
	<u>yellow clay</u>	<u>40</u>	<u>68</u>
	<u>Fine Sand & clay</u>	<u>68</u>	<u>73</u>
	<u>Fine Sand</u>	<u>73</u>	<u>86</u>
	<u>Coarse Water Sand</u>	<u>86</u>	<u>122</u>
WELL PURPOSE: <u>Home use</u> (home, irrigation, municipal, industrial)			
WELL COMPLETION DATA: (1) diameter (inches) <u>2"</u> (2) total depth (feet) <u>122'</u> (3) static water level (feet) <u>86</u> below above top of ground. (4) casing <u>Plastic</u> , <u>118</u> , (material) (depth) <u>2"</u> if telescope see back. (size) (5) screen <u>4'</u> , (length) (depth to top) <u>8 slot</u> , <u>Stainless steel</u> (size) (material) (6) pump <u>1</u> <u>7</u> (HP) (yield gpm) <u>Elec.</u> (type power) (7) electric log <u>no</u> (yes or no) (organization running log)			
(8) how well bottom plugged <u>Wash water</u>			


OCT 22 1969

MISS. BD. OF
 WATER COMMISSIONERS

DRILLERS REMARKS:

If well telescopes please sketch and show depths.

GROUND LEVEL

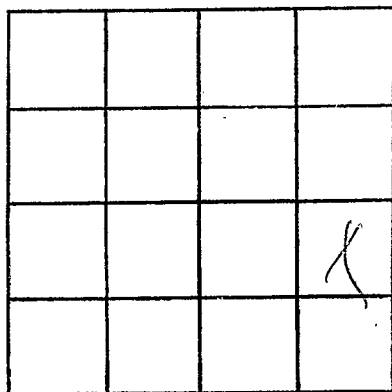

SECTION 26

Please indicate well location X.

ADDITIONAL INFORMATION

If more than one screen,
show locations of each on sketch.