

Smith Co  
 11  
 5-12-70

MISSISSIPPI  
 BOARD OF WATER COMMISSIONERS  
 416 North State Street  
 Jackson, Mississippi 39201

WATER WELL DRILLERS LOG

Smith  
 Jones

May 12 1970 date well completed  
 20 Roy Westwater wells firm name  
 Jones county well located

LANDOWNER: J.R. Stinger  
 Rt 2  
 Bay Springs  
 (mailing address)

description of formations encountered	from	to
Clay	0	8
Sand and gravel	8	28
lime rock	28	35
Blue Clay	35	150
Sand	150	170

WELL LOCATION:  
 sec. 4 T. 1 N. R. 9 E. 194  
 S W  
 8 miles west of Bay Springs  
 (distance) (direction) (nearest town)

WELL PURPOSE: home  
 (home, irrigation, municipal, industrial)

- WELL COMPLETION DATA:
- (1) diameter (inches) 2 in
  - (2) total depth (feet) 170 in
  - (3) static water level (feet) 0.6 below top of ground above
  - (4) casing galv, 160 (material) (depth)
  - (size) if telescope see back.
  - (5) screen 10 ft, 160 (length) (depth to top)
  - 1/4 St Steel (size) (material)
  - (6) pump 1 (HP) 8 (yield gpm)
  - REA (type power)
  - (7) electric log NO (yes or no)


(organization running log)  
 (8) how well bottom plugged wash water

DRILLERS REMARKS:

MAY 20 1970  
 MISS. BD. OF WATER COMMISSIONERS

If well telescopes please sketch and show depths.

GROUND LEVEL

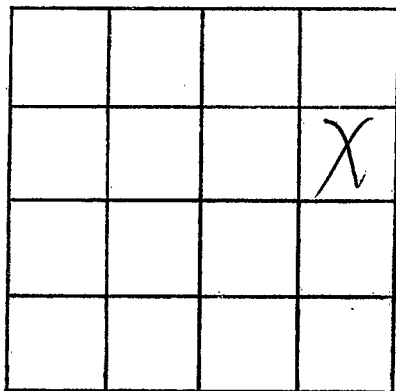

SECTION 4

Please indicate well location X.

ADDITIONAL INFORMATION

If more than one screen,  
show locations of each on sketch.