

Smith
 12
 7-21-70

MISSISSIPPI
 BOARD OF WATER COMMISSIONERS
 416 North State Street
 Jackson, Mississippi 39201

CODED

WATER WELL DRILLERS LOG

7/21/70 date well completed 19 J.P. Parker Water Well Drill firm name Smith county well located

LANDOWNER: Hubert Hill

description of formations encountered

from to

RT-3
Taylorville Miss
 (mailing address)

Red clay	0	20
Sand	20	60
Chalk	60	95
Water sand	8.5	120

WELL LOCATION:

sec. 21 T-1 N 9 E
10 miles North of Taylorville
 (distance) (direction) (nearest town)

WELL PURPOSE:
 (home, irrigation, municipal, industrial)

WELL COMPLETION DATA:

- (1) diameter (inches) 4
- (2) total depth (feet) 120 FT
- (3) static water level (feet) 65 below above top of ground.
- (4) casing PLASTIC, 11.5
 (material) (depth)

CODED

_____ if telescope see back.
 (size)

- (5) screen 5 FT, 120 FT
 (length) (depth to top)
1 1/2", STEEL
 (size) (material)

- (6) pump 1, 7
 (HP) (yield gpm)
JET
 (type power)

- (7) electric log _____
 (yes or no)

_____ (organization running log)

- (8) how well bottom plugged Chalk

JUL 27 1970


DRILLERS REMARKS:

MISS. BD. OF
 WATER COMM.

If well telescopes please sketch and show depths.

GROUND LEVEL

R9 E

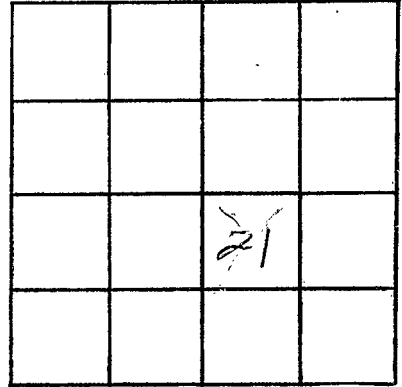

SECTION _____

Please indicate well location X.

ADDITIONAL INFORMATION

9. 120 5.31 96. 25
 100' 100' 100' 100'
 100' 100' 100' 100'
 100' 100' 100' 100'
 100' 100' 100' 100'

If more than one screen, show locations of each on sketch.