

SMITH
 Ø 13
 10-8-70

MISSISSIPPI
 BOARD OF WATER COMMISSIONERS
 416 North State Street
 Jackson, Mississippi 39201

CODED

WATER WELL DRILLERS LOG

10-8-70 date well completed 1970 W.K. Barnes & Sons, Inc. firm name Smith county well located

LANDOWNER: Willie A Gee
Route 3
Saylorville, Miss
 (mailing address)

description of formations encountered	from	to
Red Clay	0	8
Fine sand	8	26
yellow clay Hard	26	34
Rock	34	96
Fine sand	96	104
Course sand	104	154

WELL LOCATION:
 sec. 17 T. 1 N. R. 10 E.
8 miles SW of Bay Springs
 (distance) (direction) (nearest town)

WELL PURPOSE: Home
 (home, irrigation, municipal, industrial)

- WELL COMPLETION DATA:
- (1) diameter (inches) 2"
 - (2) total depth (feet) 144
 - (3) static water level (feet) 105 below above top of ground.
 - (4) casing Galv. (material) (depth) 3"
~~2"~~ If telescope see back. (size)
 - (5) screen 4" (length) (depth to top) 3'
06 slot (size) S. (material)
 - (6) pump 1-HP (HP) 5 (yield gpm)
Glee (type power)
 - (7) electric log no (yes or no)
 - (organization running log)
 - (8) how well bottom plugged Wash. valve

CODED


NOV 18 1970

DRILLERS REMARKS:

MISS. BD. OF
 WATER COMM.

If well telescopes please sketch and show depths.

GROUND LEVEL

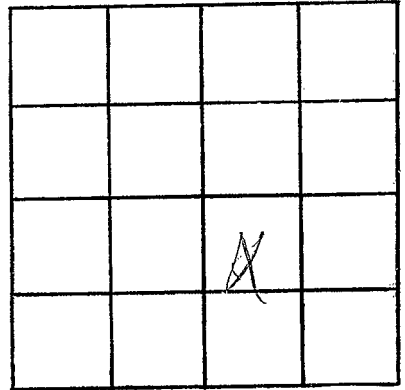

SECTION 17

Please indicate well location X.

ADDITIONAL INFORMATION

If more than one screen,
show locations of each on sketch.