

**CODED**

FEB 17 1971

MISSISSIPPI  
BOARD OF WATER COMMISSIONERS  
416 North State Street  
Jackson, Mississippi 39201

MISS. BD. OF  
WATER COMM.

**WATER WELL DRILLERS LOG**

SMITH  
Ø14  
1-16-71

1-16 1971 W.K. Baines Water Wells Smith  
date well completed firm name county well located

LANDOWNER: Lee Harrison	description of formations encountered		from	to
Bay Springs Route 2 (mailing address)	Red Clay		0	12
	Red Sand		12	30
	White Sand		30	89

WELL LOCATION:  
sec. 15 T 1 N S R 10 E  
\_\_\_\_\_ miles \_\_\_\_\_ of \_\_\_\_\_  
(distance) (direction) (nearest town)

WELL PURPOSE: Home use  
(home, irrigation, municipal, industrial)


- WELL COMPLETION DATA:
- (1) diameter (inches) 2"
  - (2) total depth (feet) 89
  - (3) static water level (feet) 60 below above top of ground.
  - (4) casing Galv. (material), (depth),  
2" If telescope see back.  
(size)
  - (5) screen 4' (length), (depth to top)  
0.7" Stainless Steel (size) (material)
  - (6) pump 3/4 (HP) (yield gpm)  
Elec. (type power)
  - (7) electric log NO (yes or no)
  - (organization running log)
  - (8) how well bottom plugged Wash Valve

**CODED**

DRILLERS REMARKS:

If well telescopes please sketch and show depths.

GROUND LEVEL

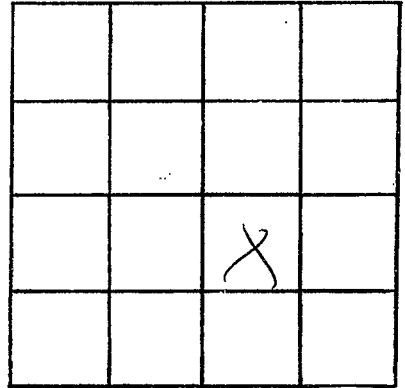

SECTION 15

Please indicate well location X.

ADDITIONAL INFORMATION

If more than one screen,  
show locations of each on sketch.