

SMITH  
 015  
 1-28-71

MISSISSIPPI  
 BOARD OF WATER COMMISSIONERS  
 416 North State Street  
 Jackson, Mississippi 39201

FEB 17 1971

MISS. BD. OF  
 WATER COM.

WATER WELL DRILLERS LOG

**CODED**

1-28-71 date well completed 1971 W.K. Barnes Water W. Smith firm name Smith county well located

LANDOWNER: <u>Jack Blackwell</u>	description of formations encountered	from	to
<u>Route 2</u>			
<u>Bay Springs miss.</u> (mailing address)	<u>Red Clay</u>	<u>0</u>	<u>12</u>
	<u>Red Sand</u>	<u>12</u>	<u>22</u>
	<u>Fine white sand</u>	<u>22</u>	<u>50</u>
	<u>Course Sand</u>	<u>50</u>	<u>69</u>

WELL LOCATION:  
 sec. 14 T. 1 N. S. R. 9  
 miles of (distance) (direction) of (nearest town)

WELL PURPOSE: HOME  
 (home, irrigation, municipal, industrial)


- WELL COMPLETION DATA:
- (1) diameter (inches) 2
  - (2) total depth (feet) 109
  - (3) static water level (feet) 36 below above top of ground.
  - (4) casing Galv. (material), (depth)
  - 2" (size) if telescope see back.
  - (5) screen 4' (length), (depth to top)
  - 0.7 (size), Stainless S. (material)
  - (6) pump 3/4 (HP), 12 (yield gpm)
  - Plec. (type power)
  - (7) electric log no (yes or no)
  - (organization running log)
  - (8) how well bottom plugged Wash down

**CODED**

DRILLERS REMARKS:

If well telescopes please sketch and show depths.

GROUND LEVEL

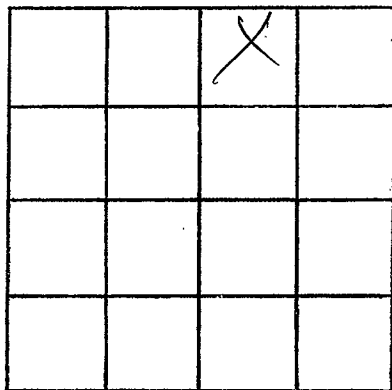

SECTION 14

Please indicate well location X.

ADDITIONAL INFORMATION

If more than one screen,  
show locations of each on sketch.