

SMITH  
 016  
 9-30-71

MISSISSIPPI  
 BOARD OF WATER COMMISSIONERS  
 416 North State Street  
 Jackson, Mississippi 39201

**CODED**

WATER WELL DRILLERS LOG

9-30 date well completed    1971 W.K. Barnes Water Wells firm name    Smith county well located

LANDOWNER: Terry Woodham  
Rt. 2  
Bay Spines Miss.  
 (mailing address)

description of formations encountered	from	to
Red Clay	0	10
Red Sand	10	28
White Dry Sand	28	80
yellow clay	80	96
fine sand	96	130
yellow clay	130	162
fine sand	162	200
Small rock	200	201
fine sand	201	265

WELL LOCATION:  
 sec. 13 T. 1 (N) S R. 9E  
6 miles South of Bay Spines  
 (distance) (direction) (nearest town)

WELL PURPOSE: Domestic  
 (home, irrigation, municipal, industrial)

- WELL COMPLETION DATA:
- (1) diameter (inches) 4"
  - (2) total depth (feet) 265
  - (3) static water level (feet) 140 below above top of ground.
  - (4) casing Galv. 249  
 (material) (depth)  
2 1/2 if telescope see back.  
 (size)
  - (5) screen 16 ft. (length) (depth to top)  
0 3/8 Stainless Steel  
 (size) (material)
  - (6) pump 1 1/2 Sub 35  
 (HP) (yield gpm)  
elec.  
 (type power)
  - (7) electric log no.  
 (yes or no)
  - (organization running log)
  - (8) how well bottom plugged Washed line

**CODED**


OCT 27 1971

Miss. Bd. of Water Comm. 86

DRILLERS REMARKS:

If well telescopes please sketch and show depths.

GROUND LEVEL

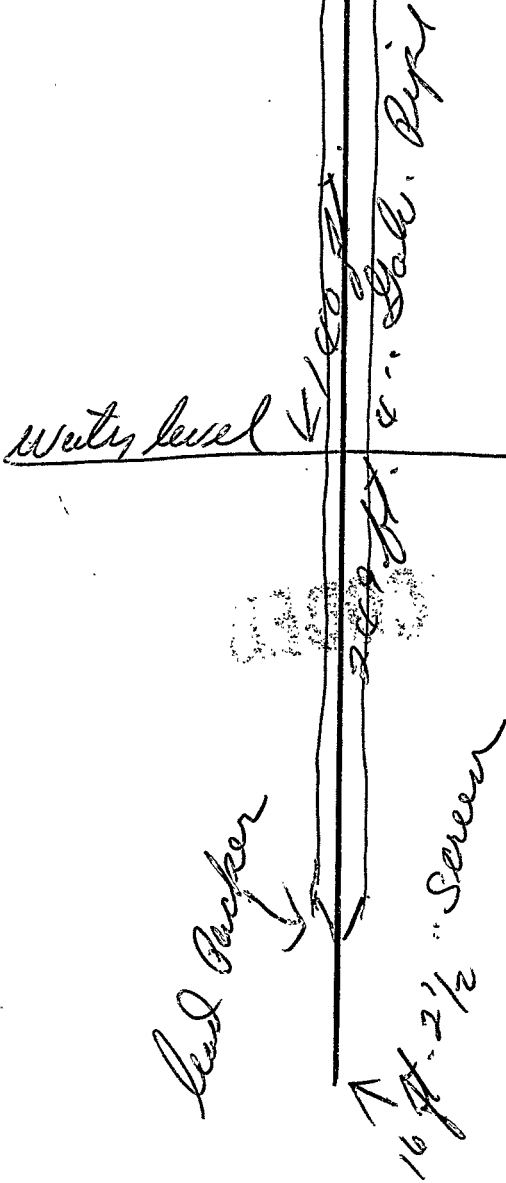

			X

SECTION 13

Please indicate well location X.

ADDITIONAL INFORMATION

If more than one screen, show locations of each on sketch.