

SMITH

020

7-27-74

MISSISSIPPI
 BOARD OF WATER COMMISSIONERS
 416 North State Street
 Jackson, Mississippi 39201

CODED

WATER WELL DRILLERS LOG

July 27 1974 Roy West Water Wells Smith
 date well completed firm name county well located

LANDOWNER: W.B. Gelmer

Rt 3

Taylorville (mailing address)

description of formations encountered

from to

Clay	0	4
sandy clay	14	20
sand	20	57
sandy clay	52	70
blue clay	70	160
sand	160	172

WELL LOCATION:

sec. 32 T-1 N R-9 E
 6 miles S 71.9° W of Taylorville
 (distance) (direction) (nearest town)

WELL PURPOSE: home (home, irrigation, municipal, industrial)

WELL COMPLETION DATA:

- (1) diameter (inches) 7
- (2) total depth (feet) 172
- (3) static water level (feet) 120 below top of ground.
- (4) casing galv 168 (material) (depth)

CODED

(size) if telescope see back.

- (5) screen 5 168 (length) (depth to top)
 2 in. steel (size) (material)

- (6) pump 1 1/2 7 (HP) (yield gpm)
 R&A (type power)

- (7) electric log 70 (yes or no)

(organization running log)

- (8) how well bottom plugged washed


RECEIVED

AUG - 8 1974

DRILLERS REMARKS:

If well telescopes please sketch and show depths.

GROUND LEVEL

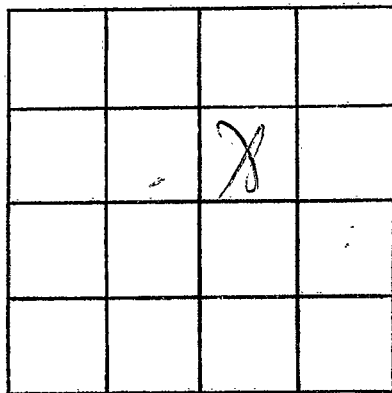

SECTION 32

Please indicate well location X.

ADDITIONAL INFORMATION

If more than one screen,
show locations of each on sketch.