

MISSISSIPPI DEPARTMENT OF NATURAL RESOURCES  
Bureau of Land and Water Resources

Southport Mall  
P.O. Box 10631

Jackson, Mississippi 39209

WATER WELL DRILLERS LOG

CODED

Smith  
Q23  
5-11-81

Griner Drilling Service, Inc.

Smith  
Jasper

5-11-81 date well completed      firm name      county well located

LANDOWNER:  
Shell Oil Company  
P.O. Box 61555  
New Orleans, La.  
(mailing address)

description of formations encountered	from	to
<u>sand</u>	<u>0</u>	<u>126</u>
<u>chalk + rock</u>	<u>126</u>	<u>189</u>
<u>streaked sand</u>	<u>189</u>	<u>315</u>
<u>sw chalk</u>	<u>315</u>	<u>567</u>
<u>streaked sand</u>	<u>567</u>	<u>630</u>
<u>sand shell</u>	<u>630</u>	<u>750</u>
<u>sand</u>	<u>750</u>	<u>810</u>
<u>chalk</u>	<u>810</u>	<u>840</u>

WELL LOCATION: 495' N + 420' W  
MSD 4-1 sec. 4 T. 1 N. R. 9 E. of W 567' cor  
Tallahala Creek  
(distance) Field (nearest town)

WELL PURPOSE: oil field  
(home, irrigation, municipal, industrial, supply)

WELL COMPLETION DATA:

- (1) diameter (inches) 4"
- (2) total depth (feet) 840'
- (3) static water level (feet) 70' (below/above top of ground)
- (4) casing Steel, 819' (material), (depth)  
4" (size) if telescope see back.
- (5) screen 42', 777' (length), (depth to top)  
4" (size), perforated (material)
- (6) pump —, 80 (HP), (yield gpm)  
AC (type power)
- (7) electric log — (yes or no)  
(organization running log)

CODED

DEPT. OF NATURAL RESOURCES  
BUREAU OF LAND & WATER RESOURCES

MAY 28 1981


(8) how well bottom plugged orange  
peel

DRILLERS REMARKS:

RECEIVED

If well telescopes please sketch and show depths.

GROUND LEVEL

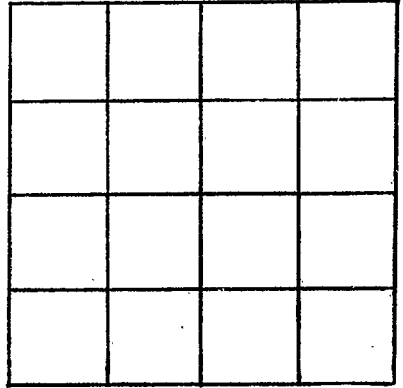

SECTION \_\_\_\_\_

Please indicate well location X.

ADDITIONAL INFORMATION

Lined area for providing additional information.

If more than one screen, show locations of each on sketch.