

MISSISSIPPI DEPARTMENT OF NATURAL RESOURCES

Bureau of Land and Water Resources

Southport Mall  
P.O. Box 1063 **CODED**

Jackson, Mississippi 39209

WATER WELL DRILLERS LOG

*Gunter Drilling Service, Inc.*

*Smith*

*Smith*  
*Ø 24*  
*8-25-81*

*8-25-81* date well completed      *Gunter Drilling Service, Inc.* firm name      *Smith* county well located

LANDOWNER:	description of formations encountered	from	to
<i>Shell Oil Company</i> <i>P.O. Box 61555</i> <i>New Orleans, La 70160</i> <small>(mailing address)</small>	<i>sand</i>	<i>0</i>	<i>252</i>
WELL LOCATION: <i>215W + 500'E of</i> <i>NO 4-13 4</i> sec. <i>4</i> T <i>1</i> N R <i>9</i> E <i>SW 1/4</i> <i>MODURFL Tallahala Creek Field</i> <small>(distance) (direction) of (nearest town)</small>	<i>chalk, rock</i>	<i>252</i>	<i>430</i>
WELL PURPOSE: <i>Oil field</i> <small>(home, irrigation, municipal, industrial)</small>	<i>sand</i>	<i>430</i>	<i>450</i>
WELL COMPLETION DATA: (1) diameter (inches) <i>4"</i>	<i>chalk, rock</i>	<i>450</i>	<i>876</i>
(2) total depth (feet) <i>1283'</i>	<i>sand</i>	<i>876</i>	<i>924</i>
(3) static water level (feet) <i>200'</i> <small>(below above top of ground)</small>	<i>chalk, rock</i>	<i>924</i>	<i>1283</i>
(4) casing <i>steel</i> , <i>924'</i> <small>(material) (depth)</small>			
<i>4"</i> <small>(size) If telescope see back.</small>			
(5) screen <i>42'</i> , <i>882'</i> <small>(length) (depth to top)</small>			
<i>4"</i> , <i>perforated</i> <small>(size) (material)</small>			
(6) pump <i>—</i> , <i>80</i> <small>(HP) (yield gpm)</small>			
<i>AC</i> <small>(type power)</small>			
(7) electric log <i>—</i> <small>(yes or no)</small>			
<i>AC</i> <small>(organization running log)</small>			
(8) how well bottom plugged <i>orange</i>			
<i>peel</i>			
DRILLERS REMARKS:			


DEPT. OF NATURAL RESOURCES  
BUREAU OF LAND & WATER RESOURCES

SEP 28 1981

**RECEIVED**

If well telescopes please sketch and show depths.

GROUND LEVEL

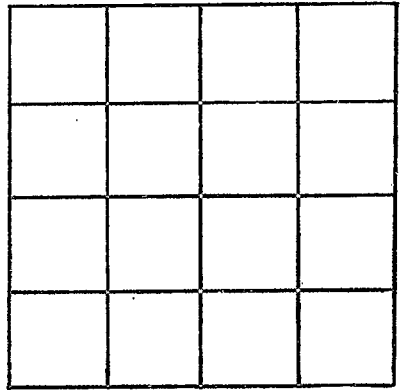

SECTION \_\_\_\_\_

Please indicate well location X.

ADDITIONAL INFORMATION

If more than one screen, show locations of each on sketch.