

SMITH
 025
 11/19/82
 Log # 198

MISSISSIPPI
 BOARD OF WATER COMMISSIONERS
 416 North State Street
 Jackson, Mississippi 39201

CODED

WATER WELL DRILLERS LOG

CODED

Nov. 19 1982 C.P. Clark Water Wells Smith
 date well completed firm name county well located

LANDOWNER: Ellis Cooper
 Myrick, Route 2, Box 100
 Bay Springs, Miss
 (mailing address)

WELL LOCATION:
 sec. 12 T 1 N R 9 E
 4 miles SW of Bay Springs
 (distance) (direction) (nearest town)

WELL PURPOSE: Home/Farm
 (home, irrigation, municipal, industrial)

- WELL COMPLETION DATA:
- (1) diameter (inches) 4
 - (2) total depth (feet) 369'
 - (3) static water level (feet) 225' below top of ground
 - (4) casing Galv. 350'
 (material) (depth)
 (size) if telescope see back.
 - (5) screen 10' 350'
 (length) (depth to top)
 4" Stainless Steel
 (size) (material)
 - (6) pump 3 25@0psi
 (HP) (yield gpm)
 220V 1Ø
 (type power)
 - (7) electric log Yes
 (yes or no)
 Bureau of Geol.
 (organization running log)
 - (8) how well bottom plugged BWV
 4" x 2" Swage

description of formations encountered	from	to
Top soil	0	2
Red sandy clay	2	15
Reddish yellow sand	15	97
Ferruginous rock	97	97 1/2
Sand	97 1/2	102
Clay	102	161
Silt	161	163
Silty clay & clay sandy streaks	163	245
Clay	245	268
Sand	268	270
Clay, dark gray	270	308
Clay, sandy, marly	308	318
Hard streak, purple	318	318 1/2
Clay	318 1/2	346
Sandy streaks	346	348
Sandy marl w/ clay str.	348	352
Sandy marl	352	370
Clay	370	376
Sand	376	395
Clay	395	410

CODED

DEPT. OF NATURAL RESOURCES
 BUREAU OF LAND & WATER RESOURCES


NOV 20 1982

RECEIVED

DRILLERS REMARKS:

If well telescopes please sketch and show depths.

GROUND LEVEL

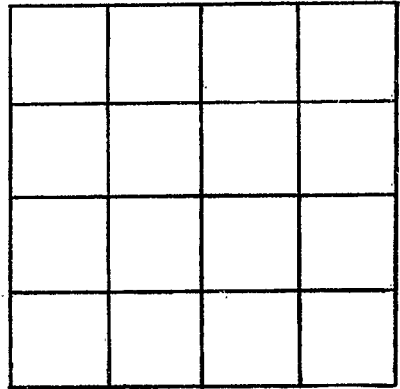

SECTION _____

Please indicate well location X.

ADDITIONAL INFORMATION

If more than one screen, show locations of each on sketch.