

SMITH
 Ø27
 7-25-83
 E log # 201

MISSISSIPPI
 BOARD OF WATER COMMISSIONERS
 416 North State Street
 Jackson, Mississippi 39201

CODED

WATER WELL DRILLERS LOG

9-25-1983 date well completed
 Gummwellsor Smith firm name
 county well located

LANDOWNER:
 HECTOR Y HALL COOD FRANKS
 (mailing address)

description of formations encountered	from	to
SAND	0	150
CLAY	150	250
SAND	250	270

WELL LOCATION:
 sec. 14 T 1 N R 9 E
 S W
 (distance) miles (direction) of (nearest town)

CODED

WELL PURPOSE:
 (home, irrigation, municipal, industrial)

WELL COMPLETION DATA:

(1) diameter (inches) 4 9

(2) total depth (feet) 270

(3) static water level (feet) 222 below top of ground.

(4) casing PUC 250 (material) (depth)

4 (size) if telescope see back.

(5) screen 20 250 (length) (depth to top)

4 PUC (size) (material)

(6) pump 3 30 (HP) (yield gpm)

(type power)

(7) electric log (yes or no)

(organization running log)

(8) how well bottom plugged BCU

DRILLERS REMARKS:


DEPT. OF NATURAL RESOURCES
 BUREAU OF LAND & WATER RESOURCES

NOV - 7 1983

RECEIVED

If well telescopes please sketch and show depths.

GROUND LEVEL

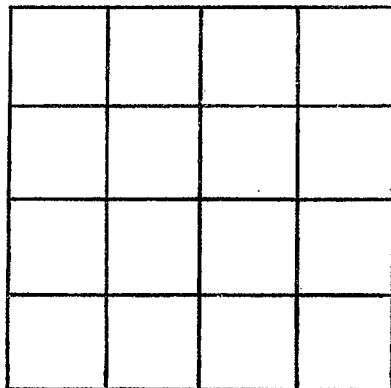

SECTION _____

Please indicate well location X.

ADDITIONAL INFORMATION

If more than one screen,
show locations of each on sketch.